

NESHOPA
E26
10-10-62

WATER WELL DRILLERS LOG

CODED

Date: 10-10, 1962, Driller: P.P. Nicholson County Neshoba
P.B. 76 Bonnie Benson (Name)

(1) Owner of Land: U.S. Mont.
(Name)
Phila. Miss.
(Address)
21 1110

(2) Location: 1/4, 1/4, 21 1110 Sec. T R
11 miles west, of Phila.
(distance) (direction) (Nearest Town)

(3) Topography: Hilly
(Hilly) (Flat) (Level)

(4) Purpose of Well: Domestic
(Domestic Irrigation
Municipal, Industrial, Other)

Description & Color of Materials Sand, Clay, Red Clay, Shell, etc.	Thick- ness Feet	Depth Feet
<u>Chalk & Clay</u>	<u>0</u>	<u>28</u>
<u>Shell & Rock</u>	<u>28</u>	<u>44</u>
<u>Chalk & Sand</u>	<u>44</u>	<u>68</u>
<u>Water Sand</u>	<u>68</u>	<u>78</u>

Information upon completion of well:

(1) Diameter 3 7/8 inches.

(2) Total Depth 78 feet.

(3) Water Level 62 feet below top of ground.

(4) Cased to Point, Size 2"

(5) Screen: Size 2", Length 5 ft.


(6) Were any formations sealed against pollution?
 yes, no.

CODED

If YES depth of formation 11 ft. 4" pipe

Why Sanitary Purpose

Drillers Remarks: Cylinder
set at 72 ft

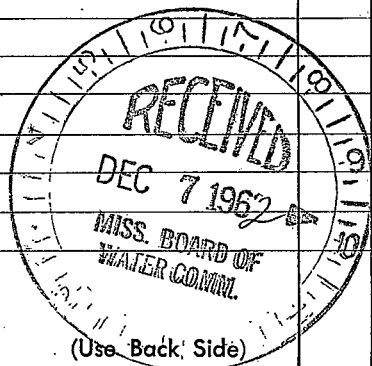

Well No.

Handwritten text at the top of the page, possibly a header or title, which is mostly illegible due to fading and bleed-through.

Handwritten text in the upper middle section, appearing as several lines of notes or a list.

Handwritten text in the middle section, continuing the notes or list from the previous block.

Handwritten text in the lower middle section, with some lines that are more clearly legible than others.

Handwritten text in the lower section, possibly concluding the notes or list.

Handwritten text at the bottom of the page, which may include a signature or a final note.