

E 28
10-8-62

WATER WELL DRILLERS LOG

CODED

Date: 10-8, 1962 Driller: PRR Nicholas County Neshoba
PR-32 Betty John (Name)

(1) Owner of Land: U S Govt
(Name) Phila Miss
(Address) 9 1110

(2) Location: 1/4, 1/4, Sec. T R
1 1/2 miles West of Phila
(distance) (direction) (Nearest Town)

(3) Topography: Hilly
(Hilly) (Flat) (Level)

(4) Purpose of Well: Domestic
(Domestic Irrigation
Municipal, Industrial, Other)

Description & Color of Materials Sand, Clay, Red Clay, Shell, etc.	Thick- ness Feet	Depth Feet
<u>Clay & Sand</u>	<u>0</u>	<u>18</u>
<u>Shed of rock</u>	<u>18</u>	<u>40</u>
<u>blue dirt</u>	<u>40</u>	<u>168</u>
<u>Shell</u>	<u>168</u>	<u>190</u>
<u>blue dirt & sand</u>	<u>190</u>	<u>260</u>
<u>Water Sand</u>	<u>260</u>	<u>273</u>

CODED

Information upon completion of well:

(1) Diameter 3 7/8 inches.

(2) Total Depth 273 feet.


(3) Water Level 160 feet below top of ground.

(4) Cased to Point, Size 2"

(5) Screen: Size 2", Length 10ft

(6) Were any formations sealed against pollution?
 yes, no.

If YES depth of formation 10ft 4" size
Why Sanitary Purpose
Drillers Remarks: Cylinder
Set at 185

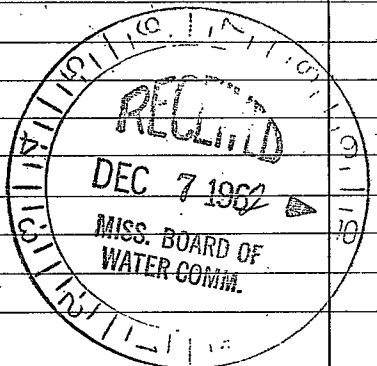

(Use Back Side)

Well No.

Handwritten notes at the top of the page, including the number '20' and various illegible scribbles.

Vertical handwritten notes on the right side of the page.

Small handwritten notes in the middle of the page.

Handwritten notes at the bottom of the page, including the number '20' and other illegible text.