

E 30
10-15-62

WATER WELL DRILLERS LOG

CODED

Date: 10-15, 1962, Driller: PR Nicholson County Neshoba
PR-18 Lesperes (Name)

(1) Owner of Land: V. D. Scott
(Name)
Phila. Miss.
(Address)
28 1110
(2) Location: 1/4, 28 Sec. T, R
13 miles West of Phila
(distance) (direction) (Nearest Town)
(3) Topography: Hilly
(Hilly) (Flat) (Level)
(4) Purpose of Well: Domestic
(Domestic Irrigation
Municipal, Industrial, Other)


Description & Color of Materials Sand, Clay, Red Clay, Shell, etc.	Thick- ness Feet	Depth Feet
<u>Clay & Sand</u>	<u>0</u>	<u>45</u>
<u>rock</u>	<u>45</u>	<u>70</u>
<u>blue dirt & Sand</u>	<u>70</u>	<u>75</u>
<u>Shell</u>	<u>125</u>	<u>170</u>
<u>Water sand</u>	<u>170</u>	<u>188</u>

Information upon completion of well:

(1) Diameter 3 7/8 inches.
(2) Total Depth 188 feet.
(3) Water Level 155 feet below top of ground.
(4) Cased to Joint, Size 2"
(5) Screen: Size 2", Length 10ft
(6) Were any formations sealed against pollution?
✓ yes, no.

If YES depth of formation 11 ft 4" Pipe
Why Sanitary Purpose
Drillers Remarks: Cylinder
173 ft

CODED

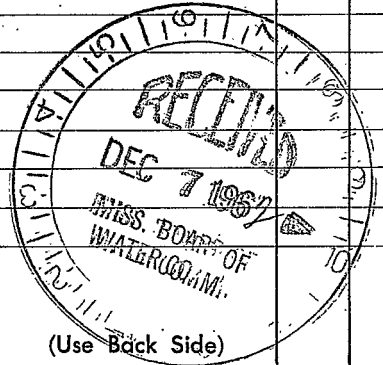

Well No.

Handwritten notes at the top of the page, including the date "1975" and the name "John".

Vertical handwritten notes on the right side of the page.

Handwritten notes at the bottom of the page, including the name "John" and the date "1975".