

NEHOBA

E32

10-16-62

WATER WELL DRILLERS LOG

CODED

Date: 10-16, 1962, Driller: B. P. Nicholson County: Nechoda  
PR-17 Henry Bell (Name)

(1) Owner of land: U.S. Govt.  
(Name)  
Phila. Miss  
(Address)  
28 1110  
(2) Location: 1/4, 1/4, Sec. T R  
13 miles west of Phila.  
(distance) (direction) (Nearest Town)  
(3) Topography: Hilly  
(Hilly) (Flat) (Level)  
(4) Purpose of Well: Domestic  
(Domestic Irrigation  
Municipal, Industrial, Other)


Description & Color of Materials Sand, Clay, Red Clay, Shell, etc.	Thick- ness Feet	Depth Feet
Clay & Sand	20	40
water Sand	40	50

CODED

Information upon completion of well:

(1) Diameter 3 7/8 inches.  
(2) Total Depth 50 feet.  
(3) Water Level 38 feet below top of ground.  
(4) Cased to Point, Size 2"  
(5) Screen: Size 2", Length 5ft  
(6) Were any formations sealed against pollution?  
yes, no.

If YES depth of formation 11 ft 4" pipe  
Why Sanitary Purpose  
Drillers Remarks: Cylinder Set  
at 44 ft

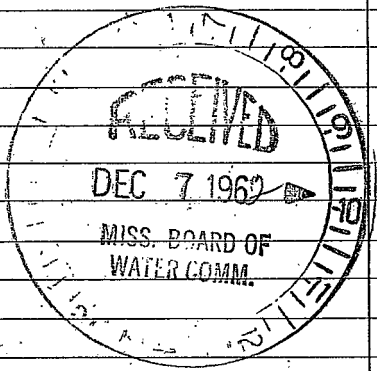

(Use Back Side)

Well No.

1914

1914

