

E 33

WATER WELL DRILLERS LOG

CODED

10-17-62

Date: 10-17, 1962, Driller: P. A. Nicholson, County: Neshoba

PR-287 Hanson Willie

(1) Owner of Land: U S Gout
 (Name)
Phila Wise
 (Address)
22 11 10
 (2) Location: 1/4, 22 11 10, 1/4, Sec. T R
14 miles West, of Phila
 (distance) (direction) (Nearest Town)
 (3) Topography: Hilly
 (Hilly) (Flat) (Level)
 (4) Purpose of Well: Domestic
 (Domestic Irrigation
 Municipal, Industrial, Other)


Description & Color of Materials Sand, Clay, Red Clay, Shell, etc.	Thick- ness Feet	Depth Feet
<u>Chalk Sand</u>	<u>0</u>	<u>8</u>
<u>rock</u>	<u>8</u>	<u>20</u>
<u>Chalk Sand</u>	<u>20</u>	<u>34</u>
<u>Water Sand</u>	<u>34</u>	<u>42</u>

Information upon completion of well:

(1) Diameter 3 7/8 inches.
 (2) Total Depth 42 feet.
 (3) Water Level 32 feet below top of ground.
 (4) Cased to Point, Size 2"
 (5) Screen: Size 2", Length 5 ft
 (6) Were any formations sealed against pollution?
 yes, no.

CODED

If YES depth of formation 10 ft 4" Pipe
 Why Sanitary Purpose
 Drillers Remarks: Cylinder
set at 37 ft

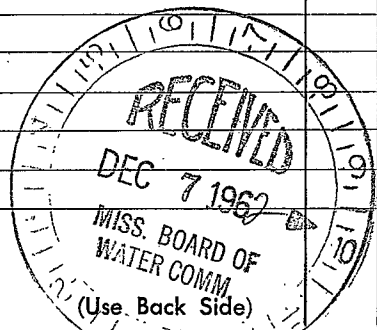

Well No.

