

NESHOBIA

E34

10-19-62

WATER WELL DRILLERS LOG

CODED

Date: 10-19, 1962, Driller: P. R. Nicholas County: Neshoba

PR-30 Jeff Jubber

(Name)

(1) Owner of Land: Shila - Miss - (Name) (Address)

(2) Location: 22 1110 1/4, 1/4, Sec. T. R. 14 miles west of Shila (distance) (direction) (Nearest Town)

(3) Topography: Hilly (Hilly) (Flat) (Level)

(4) Purpose of Well: Domestic (Domestic Irrigation, Municipal, Industrial, Other)

Description & Color of Materials Sand, Clay, Red Clay, Shell, etc.	Thick- ness Feet	Depth Feet
Clay & sand	0	40
Chalk & sand	40	55
Water sand	55	66

CODED

Information upon completion of well:

(1) Diameter 3 7/8 inches.

(2) Total Depth 66 feet.

(3) Water Level 53 feet below top of ground.

(4) Cased to Joint, Size 2"


(5) Screen: Size 2" Length 5 ft

(6) Were any formations sealed against pollution? yes, no.

If YES depth of formation 10 ft 4" pipe

Why Sanitary Purpose

Drillers Remarks: Cylinder set at 59 ft

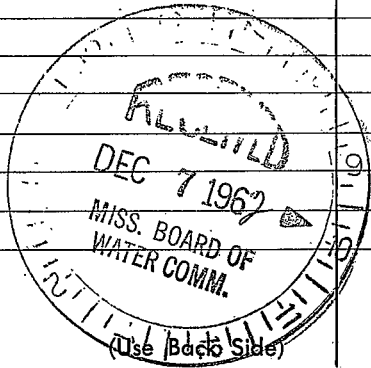

Well No.

