

E35  
10-23-62

WATER WELL DRILLERS LOG **CODED**

Date: 10-23, 1962, Driller: P.R. McMichael County: Neshoba  
PR-25 Katherine Wingo (Name)

- (1) Owner of Land: U.S. Govt.  
(Name)  
Phila. Miss.  
(Address)
- (2) Location: 22 11/10  
1/4, 1/4, Sec. T R  
14 miles West of Phila.  
(distance) (direction) (Nearest Town)
- (3) Topography: Hilly  
(Hilly) (Flat) (Level)
- (4) Purpose of Well: Domestic  
(Domestic Irrigation  
Municipal, Industrial, Other)


Description & Color of Materials Sand, Clay, Red Clay, Shell, etc.	Thick- ness Feet	Depth Feet
<u>Clay &amp; sand</u>	<u>0</u>	<u>25</u>
<u>rock</u>	<u>25</u>	<u>40</u>
<u>Chalk &amp; sand</u>	<u>40</u>	<u>48</u>
<u>Water Sand</u>	<u>48</u>	<u>58</u>

**CODED**

Information upon completion of well:

- (1) Diameter 3 7/8 inches.
- (2) Total Depth 58 feet.
- (3) Water Level 45 feet below top of ground.
- (4) Cased to Point, Size 2"
- (5) Screen: Size 2", Length 5ft
- (6) Were any formations sealed against pollution?  
✓ yes,        no.

If YES depth of formation 11 ft 4" Pipe  
Why Sanitary Purpose  
Drillers Remarks: Cylinder  
Cylinder set at 50ft

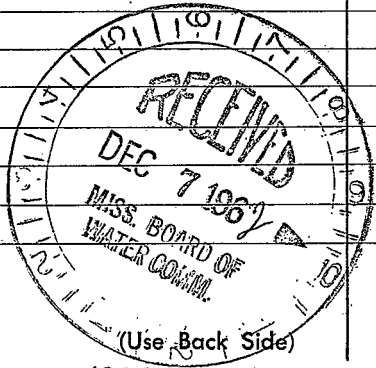

Well No.

