

NESHOBA

E 36
10-24-62

WATER WELL DRILLERS LOG

CODED

Date: 10-24, 1962, Driller: R R Nicholson County Neshoba

PR-18 H5 good

(Name)

(1) Owner of Land: V S Scott
 (Name)
Phila. Miss
 (Address)
27 1110

(2) Location: 1/4, 1/4, Sec. T R
14 1/2 miles West, of Phila.
 (distance) (direction) (Nearest Town)

(3) Topography: Hilly
 (Hilly) (Flat) (Level)

(4) Purpose of Well: Domestic
 (Domestic Irrigation
 Municipal, Industrial, Other)

Description & Color of Materials Sand, Clay, Red Clay, Shell, etc.	Thick- ness Feet	Depth Feet
<u>Clay Sand</u>	<u>0</u>	<u>14</u>
<u>rock shell</u>	<u>14</u>	<u>40</u>
<u>water sand</u>	<u>40</u>	<u>56</u>

CODED

Information upon completion of well:

(1) Diameter 3 7/8 inches.

(2) Total Depth 56 feet.

(3) Water Level 38 feet below top of ground.

(4) Cased to Joint, Size 2"


(5) Screen: Size 2", Length 5 ft

(6) Were any formations sealed against pollution?
 yes, no.

If YES depth of formation 11 ft 4" pipe

Why Sanitary purpose

Drillers Remarks: Electric
Pump

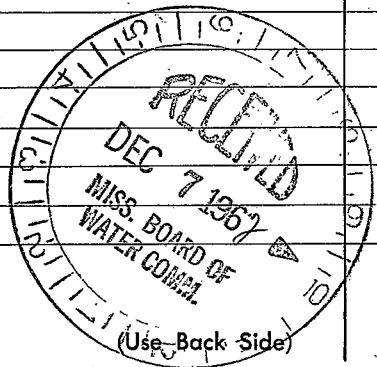

Well No.

