

NESHOPA

E 37 WATER WELL DRILLERS LOG

CODED

Date: 10-29-62, 1962, Driller: P. R. Nicholson County: Neshoba
P. R. Isaac Isaac (Name)

(1) Owner of Land: U.S. Govt. (Name)
Phila. Miss. (Address)
(2) Location: 1/4, 19 1/4, Sec. 110 T. R.
15 miles West of Phila. (distance) (direction) (Nearest Town)
(3) Topography: Hilly (Hilly) (Flat) (Level)
(4) Purpose of Well: Domestic (Domestic Irrigation Municipal, Industrial, Other)

Description & Color of Materials Sand, Clay, Red Clay, Shell, etc.	Thick- ness Feet	Depth Feet
Chalk & Sand	0	28
Rock & Shell	28	84
Blue dirt & Sand	84	105
Water Sand	105	118


Information upon completion of well:

(1) Diameter 3 7/8 inches.
(2) Total Depth 118 feet.
(3) Water Level 65 feet below top of ground.
(4) Cased to Point, Size 2"
(5) Screen: Size 2", Length 5 ft.
(6) Were any formations sealed against pollution?

CODED

yes, no.

If YES depth of formation 11 ft 4" pipe
Why Sanitary Purpose
Drillers Remarks: Cylinder at 82 ft

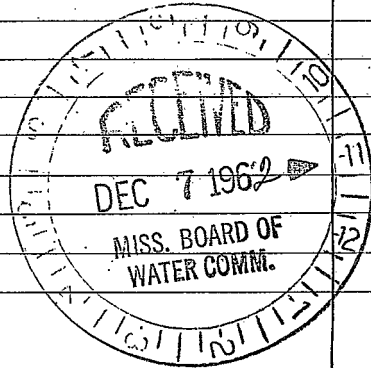

(Use Back Side)

Well No.

