

E38

WATER WELL DRILLERS LOG

CODED

10-24-62

Date: 10-24, 1962, Driller: P. R. Nicholson County Neshoba

PR-19 Roby John

(Name)

(1) Owner of Land: V S Gruit
Shale - Miss
(Name)
(Address)

Description & Color of Materials Sand, Clay, Red Clay, Shell, etc.	Thick- ness Feet	Depth Feet
Clay & Sand	0	30
Chalk & Sand	30	45
water sand	45	60

(2) Location: 1/4, 1/4, Sec. T R
15 miles west of Shale
(distance) (direction) (Nearest Town)

(3) Topography: Hilly
(Hilly) (Flat) (Level)

(4) Purpose of Well: Domestic
(Domestic Irrigation
Municipal, Industrial, Other)

Information upon completion of well:

(1) Diameter: 3 7/8 inches.

(2) Total Depth: 60 feet.

(3) Water Level: 40 feet below top of ground.

(4) Cased to Joint, Size 2"

(5) Screen: Size 2", Length 5 ft.


(6) Were any formations sealed against pollution?
 yes, no.

If YES depth of formation 11 ft 4" pipe

Why Sanitary Purpose

Drillers Remarks: Cylinder
Set at 52 ft

CODED

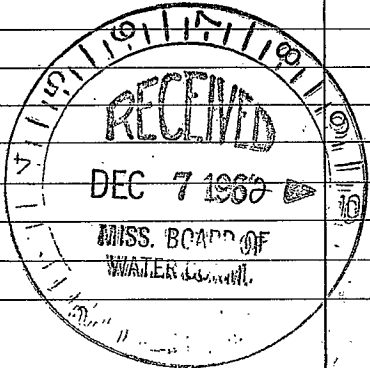

(Use Back Side)

Well No.

1950

1. The first part of the report deals with the general situation of the country and the progress of the work during the year. It is followed by a detailed account of the work done in each of the various departments.

2. The second part of the report deals with the work done in each of the various departments. It is followed by a detailed account of the work done in each of the various departments.

3. The third part of the report deals with the work done in each of the various departments. It is followed by a detailed account of the work done in each of the various departments.

4. The fourth part of the report deals with the work done in each of the various departments. It is followed by a detailed account of the work done in each of the various departments.

5. The fifth part of the report deals with the work done in each of the various departments. It is followed by a detailed account of the work done in each of the various departments.