

NESHOBAY

E 40

8-22-62

WATER WELL DRILLERS LOG

CODED

Date: 8-22 1962 Driller: B.R. Nicholson County Neshoba

PR-4 Mike Ben (Name)

(1) Owner of Land: U.S. Govt. (Name)

Shila Miss. (Address)

25 1110

(2) Location: 1/4, 1/4, Sec. T R

6 1/2 miles west Shila (distance) (direction) (Nearest Town)

(3) Topography: Hilly (Hilly) (Flat) (Level)

(4) Purpose of Well: Domestic (Domestic Irrigation Municipal, Industrial, Other)

Description & Color of Materials Sand, Clay, Red Clay, Shell, etc.	Thick- ness Feet	Depth Feet
Clay & Shell	1	8
Sand & Chalk	8	32
rock	32	33
blue dirt	33	55
Sand (dry)	55	69
rock & shell	69	105
blue dirt	105	115
water sand	115	132

Information upon completion of well:

(1) Diameter 3 7/8 inches.

(2) Total Depth 132 feet.

(3) Water Level 90 feet below top of ground.

(4) Cased to Point, Size 2"

(5) Screen: Size 2", Length 5 ft.


(6) Were any formations sealed against pollution?  yes,  no.

If YES depth of formation 32 ft 4" pipe

Why Sanitary Purpose

Drillers Remarks: Cylinder set at 105 ft

CODED

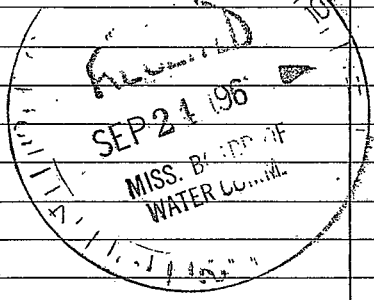

Well No.

(Use Back Side)

