

E44

WATER WELL DRILLERS LOG

CODED

6-27-62

Date: 6-27, 1962, Driller: R R Nicholas, County: Jefferson

PR 13 Seymour Comby (Name)

(1) Owner of Land: W.S. Gout. (Name) Shila Miss. (Address) 36 1110

(2) Location: 1/4, 1/4, Sec. T R, 6 miles west of Shila, (distance) (direction) (Nearest Town)

(3) Topography: Hilly (Hilly) (Flat) (Level)

(4) Purpose of Well: Domestic (Domestic Irrigation Municipal, Industrial, Other)

Information upon completion of well:

(1) Diameter: 3 7/8 inches.

(2) Total Depth: 160 feet.

(3) Water Level: 178 feet below top of ground.

(4) Cased to: Point, Size 2"

(5) Screen: Size 2", Length 5'

(6) Were any formations sealed against pollution?  yes,  no.


If YES depth of formation: 12 1/2

Why: Sanitary Purpose

Drillers Remarks: Cylinder is set a 140ft

Description & Color of Materials Sand, Clay, Red Clay, Shell, etc.	Thickness Feet	Depth Feet
Clay & Sand	1	58
Clay dirt	58	80
Sand & blue dirt	80	90
Shell	90	103
Rock	103	135
Blue dirt & Sand	135	150
Water sand	150	160

CODED

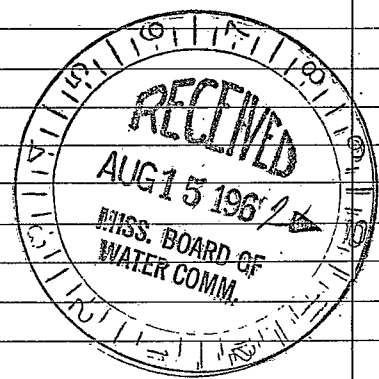

(Use Back Side)

Well No.

1000

Handwritten notes and scribbles at the top of the page, including a large, faint scribble on the left side.

1000  
1000  
1000

Handwritten notes at the bottom of the page, including the word "ASIA" and other illegible scribbles.