

WATER WELL DRILLERS LOG

CODED

E 46

8-29-62

Date: 8-29, 1962, Driller: P. R. Nicholson, County Neshoba

PR-44 - Nettie Jimmie (Name)

(1) Owner of Land: V S Gault, Phila. Miss. (Name) (Address)

(2) Location: 231110, 1/4, 1/4, Sec. T R, 6 1/2 miles West of Phila (distance) (direction) (Nearest Town)

(3) Topography: Hilly (Hilly) (Flat) (Level)


(4) Purpose of Well: Domestic (Domestic Irrigation, Municipal, Industrial, Other)

Description & Color of Materials Sand, Clay, Red Clay, Shell, etc.	Thick- ness Feet	Depth Feet
Clay	1	10
Clay & Chalk	10	25
Sand & Chalk	2.5	35
Water Sand	35	48

CODED

Information upon completion of well:

- (1) Diameter 3 7/8 inches.
- (2) Total Depth 45 feet.
- (3) Water Level 32 feet below top of ground.
- (4) Cased to Point, Size 3".
- (5) Screen: Size 2", Length 5 ft.
- (6) Were any formations sealed against pollution?
yes, no.

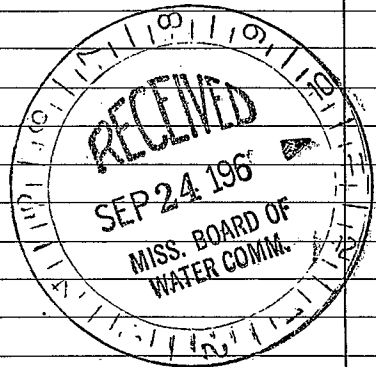

If YES depth of formation 10 ft. 4" pipe
Why Sanitary Purpose
Drillers Remarks: Cylinders set 40 ft

Well No.

(Use Back Side)

