

E47

WATER WELL DRILLERS LOG

CODED

8-28-62

Date: 8-28-62, 1962, Driller: P.R. Nicholson County: ~~Shreveport~~ Neshoba
P.R. - 46 Minnie Sue Waters (Name)

(1) Owner of Land: V S Guit.
Shila Miss.
(Name)
(Address) 251110

(2) Location: 1/4, 251110, Sec. 1, R.
6 1/2 miles West Shiles,
(distance) (direction) (Nearest Town)

(3) Topography: Hilly
(Hilly) (Flat) (Level)

(4) Purpose of Well: Domestic
(Domestic Irrigation
Municipal, Industrial, Other)

Description & Color of Materials Saffd, Clay, Red Clay, Shell, etc	Thick- ness Feet	Depth Feet
Clay & Chalk	1	20
Sand & Chalk	20	35
Water Sand	35	45

CODED

Information upon completion of well:

(1) Diameter 3 7/8 inches.

(2) Total Depth 45 feet.

(3) Water Level 30 feet below top of ground.

(4) Cased to Joint, Size 2"


(5) Screen: Size 2", Length 5 ft.

(6) Were any formations sealed against pollution?
yes, no.

If YES depth of formation 11 ft 4" pipe

Why Sanitary Purpose

Drillers Remarks: Cylinder set
40 ft

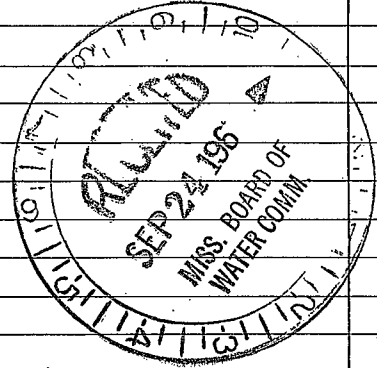

Well No.

(Use Back Side)

