

NESHUBA

E48

WATER WELL DRILLERS LOG

COL

Date: 7-2-62 Driller: R.R. Michaelson County: Jefferson

PR-5 Jeff Gohn

(1) Owner of Land: Ghila, Miss. (Name) (Address) 36 11 10

(2) Location: 1/4, 3/4, Sec. 11, T. 10, R. 6 miles West of Ghila, (distance) (direction) (Nearest Town)

(3) Topography: Hilly (Hilly) (Flat) (Level)

(4) Purpose of Well: Domestic (Domestic Irrigation, Municipal, Industrial, Other)

Description & Color of Materials Sand, Clay, Red Clay, Shell, etc.	Thick- ness Feet
Clay & Sand	1
blue & rock	65 80
mailed sand	80 95
sand & rock	95 105
rock	105 135
blue dirt & sand	135 150
water sand	150 162

Information upon completion of well:


- (1) Diameter: 3 7/8 inches.
- (2) Total Depth: 162 feet.
- (3) Water Level: 138 feet below top of ground.
- (4) Cased to: Point, Size: 2"
- (5) Screen: Size: 2", Length: 5"
- (6) Were any formations sealed against pollution?
yes, no.

If YES depth of formation: 10' - 4" Pipe

Why: Sanitary Purpose

Drillers Remarks: Cylinder set 150 ft

CODED

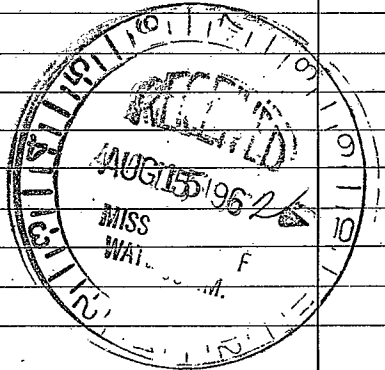

(Use Back Side)

Well No.

[The page contains extremely faint and illegible text, likely bleed-through from the reverse side of the document. The text is scattered across the page and cannot be transcribed accurately.]