

E 50

WATER WELL DRILLERS LOG

CODED

9-25-62

Date: 9-25-1962, Driller: R R Nicholson, County: Neshoba
P.R. 38 Earnest Tubley (Name)

(1) Owner of Land: U.S. Govt.
(Name) Phila. Wise
(Address) 10 11 10
(2) Location: 1/4, 1/4, Sec. T R
9 miles West of Phila.
(distance) (direction) (Nearest Town)
(3) Topography: Hilly
(Hilly) (Flat) (Level)
(4) Purpose of Well: Domestic
(Domestic Irrigation Municipal, Industrial, Other)


Description & Color of Materials Sand, Clay, Red, Clay, Shell, etc.	Thick- ness Feet	Depth Feet
Chalk & clay	0	7
Shell & rock	7	38
blue dirt	38	88
blue dirt & sand	88	94
blue dirt	94	200
Water Sand	200	223

Information upon completion of well:

(1) Diameter: 3 7/8 inches.
(2) Total Depth: 223 feet.
(3) Water Level: 165 feet below top of ground.
(4) Cased to: Joint, Size 2"
(5) Screen: Size 2", Length 10 ft.
(6) Were any formations sealed against pollution?
 yes, no.

CODED

If YES depth of formation: 10 ft 4" pipe
Why: Sanitary Purpose
Drillers Remarks: Cased
Set at 190 ft.

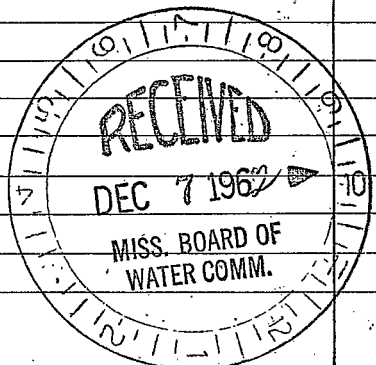

(Use Back Side)

Well No.

Handwritten text, possibly a list or notes, located in the upper portion of the page. The text is extremely faint and illegible.

Handwritten text, possibly a list or notes, located in the lower portion of the page. The text is extremely faint and illegible.