

E 54

WATER WELL DRILLERS LOG

CODED

Date: 7-4-62, 1962, Driller: B R. Nicholson County Neshoba  
PR-17 Mrs. Simpson (Name) Isaac

- (1) Owner of Land: U S Govt. (Name)  
Phila Miss (Address) 36 11 10
- (2) Location: 1/4, 1/4, Sec. T R  
7 miles west Phila (distance) (direction) (Nearest Town)
- (3) Topography: Hilly (Hilly) (Flat) (Level)
- (4) Purpose of Well: Domestic (Domestic Irrigation, Municipal, Industrial, Other)


| Description & Color of Materials<br>Sand, Clay, Red Clay, Shell, etc. | Thick-<br>ness<br>Feet | Depth<br>Feet |
|---|------------------------|---------------|
| Clay & Sand   | 1                      | 60            |
| Shell of blue dirt  | 60                     | 95            |
| Sand dry  | 95                     | 105           |
| Rock  | 105                    | 150           |
| Blue dirt & Sand  | 150                    | 225           |
| Rock  | 225                    | 240           |
| Water Sand  | 240                    | 254           |

Information upon completion of well:

- (1) Diameter 3 7/8 inches.
- (2) Total Depth 254 feet.
- (3) Water Level 725 feet below top of ground.
- (4) Cased to Joint, Size 2"
- (5) Screen: Size 2", Length 10'
- (6) Were any formations sealed against pollution?  
 yes,  no.

If YES depth of formation 11"  
Why: Sanitary Purpose  
Drillers Remarks: Cylinder is set at 235'

CODED

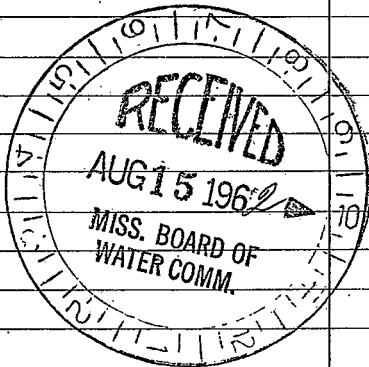

(Use Back Side)

Well No.

Handwritten notes at the top of the page, including the number "990" and various illegible scribbles.

Large area of handwritten text in the middle of the page, consisting of several lines of illegible scribbles.

Handwritten notes at the bottom of the page, including the number "100" and various illegible scribbles.