

NESHOBA
E 55
5-12-71

MISSISSIPPI
 BOARD OF WATER COMMISSIONERS
 416 North State Street
 Jackson, Mississippi 39201

CODED

WATER WELL DRILLERS LOG

May 19 1971 J. D. Company NESHOBA
 date well completed firm name county well located

LANDOWNER: Mr. Collier

description of formations encountered	from	to
	<u>Top Soil</u>	<u>0</u>
<u>Red Clay</u>	<u>6</u>	<u>16</u>
<u>Fine Sand</u>	<u>16</u>	<u>20</u>
<u>Clay</u>	<u>20</u>	<u>33</u>
<u>Coarse Sand</u>	<u>33</u>	<u>35</u>

~~Mr. Collier~~
 (mailing address)

WELL LOCATION:

sec. 32 T. 11 N. R. 10 E.
12 miles N of Oshtozo
 (distance) (direction) (nearest town)

WELL PURPOSE:

(home, irrigation, municipal, industrial)

WELL COMPLETION DATA:

- (1) diameter (inches) 9 1/2
- (2) total depth (feet) 351
- (3) static water level (feet) 30 below above top of ground.
- (4) casing (material) (depth) (size) if telescope see back.
- (5) screen 12 29 (length) (depth to top) (size) (material) Reinforced
- (6) pump 1 230 (HP) (yield gpm) (type power) Gas
- (7) electric log NO (yes or no) N 485 (organization running log)
- (8) how well bottom plugged

CODED


MAY 17 1971

MISS. BD. OF
 WATER COMM.

DRILLERS REMARKS:

If well telescopes please sketch and show depths.

GROUND LEVEL

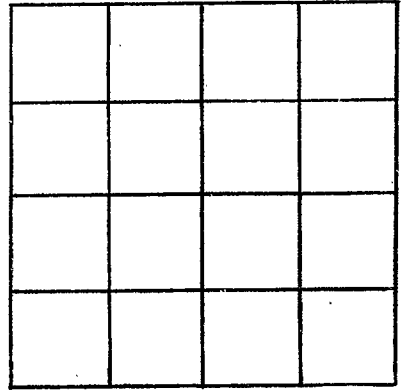

SECTION _____

Please indicate well location X.

ADDITIONAL INFORMATION

If more than one screen, show locations of each on sketch.