

Neshoba
E58
2-25-72

MISSISSIPPI
 BOARD OF WATER COMMISSIONERS
 416 North State Street
 Jackson, Mississippi 39201

CODED

WATER WELL DRILLERS LOG

2/25 1972 F. J. Comors Neshoba
 date well completed firm name county well located

LANDOWNER: Casper Thompson

description of formations encountered	from	to
<u>Red Clay</u>	<u>0</u>	<u>19</u>
<u>Coarse Sand</u>	<u>19</u>	<u>24</u>
<u>Rock</u>	<u>24</u>	<u>34</u>
<u>Coarse Sand</u>	<u>34</u>	<u>40</u>
<u>Rock</u>	<u>40</u>	<u>83</u>
<u>Coarse Sand</u>	<u>83</u>	<u>100</u>

(mailing address)

WELL LOCATION:
 sec. 18 T 11 N R 10 E
9 miles E of Edinburg
 (distance) (direction) (nearest town)

WELL PURPOSE:
 (home) irrigation, municipal, industrial

- WELL COMPLETION DATA:
- (1) diameter (inches) 2"
 - (2) total depth (feet) 100'
 - (3) static water level (feet) 80' below top of ground.
 - (4) casing 2" B.P. 94'
 (material) (depth)
2"
 (size) If telescope see back.
 - (5) screen 20 C.P. 100'
 (length) (depth to top)
2" 10 C.P.
 (size) (material)
 - (6) pump 1/2 110
 (HP) (yield gpm)
Edis.
 (type power)
 - (7) electric log no
 (yes or no)
- (organization running log)
- (8) how well bottom plugged point

CODED


FEB 28 1972

DRILLERS REMARKS:

MISSISSIPPI
 WATER BOARD

If well telescopes please sketch and show depths.

GROUND LEVEL

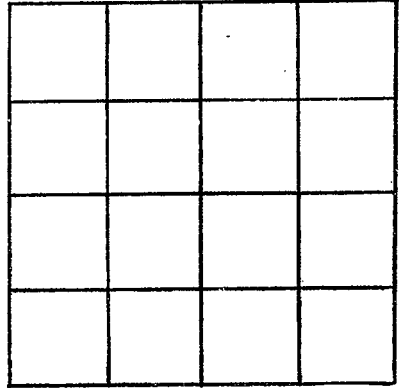

SECTION _____

Please indicate well location X:

ADDITIONAL INFORMATION

If more than one screen, show locations of each on sketch.