

Well # 2

County: Neshoba
 Permit #: _____
 Driller: Robert Anthony
 Date drilling completed: 11/23/06

State Well Report
Part 1 - Driller's Log

Mississippi Department of Environmental Quality
 Office of Land and Water Resources
 P.O. Box 10631
 Jackson, MS 39289-0631
 (601)961-5210
 (601)354-6938 (fax)

For Office Use Only:
 Aquifer: _____
 Well #: F-60
 L. S. Elevation: _____
 E-log #: _____

State Law requires that this report be prepared by the license holder responsible for the work and filed with the Department at the above address within 30 days of completion of drilling of the well or borehole.

Information on Well Owner (Landowner if borehole is not for a water well)	Well or Borehole Location
Owner Name: <u>Jeffrey Watkins</u>	Latitude: <u>32° 49' 00" N</u> Longitude: <u>89° 08' 56" W</u>
Mailing Address: <u>12720 Hwy 16 E</u>	Method of Lat/Long (circle one): Conventional Survey, USGS quad, Hand-held GPS, Survey-grade GPS
City: <u>Philadelphia</u> MS <u>39350</u>	SE 1/4 SW 1/4 Sec <u>12</u> Twn <u>11N</u> Rng <u>11E</u>
State: _____ Zip Code: _____	NE SE 10 Direction: _____ Nearest Town: _____
Telephone No. <u>(601) 656-6837</u>	Distance: <u>3.5</u> Miles <u>NW</u> of <u>Philadelphia</u>

Well / Borehole Data

Date drilling started: 10/21/06 ~~10/21/06~~ Date drilling completed: 11/23/06 Hole depth: 550' Hole diameter: 4"

Location of the source of any surface water used for drilling: City Water

Method of dosing and volume of Chlorine used in drilling and development: _____

Logs run (circle all applicable): No log run Electric Gamma Ray Density Sonic Neutron Other: _____

Name of organization running log(s): _____

Purpose of borehole (check one): Water Well Geotechnical/Geological Investigation _____ Ground Source Heat Pump _____

Seismic Survey _____ Other (describe) _____

If drilling is not related to water well construction, skip the remainder of this block

Purpose of Well (check one): Home _____ Industrial _____ Public Supply _____ Irrigation _____ Fish Culture _____ Other: Chicken Houses

If a flowing well, method of flow regulation: Valve _____ Other (describe) _____

Static Water Level: 30 feet above or below (circle one) land surface Date measured: 11/24/06

Method of Measurement (circle one) steel tape electric tape air line other: _____

Well depth: 550' Well grouted to a depth of 80 feet Type of grout (circle one): Neat Cement Bentonite Mix

Casing length: 280 feet Casing diameter: 4 inches Type of casing: PVC

Screen length: 80 feet Screen diameter: 2 inches Type of screen: PVC

Screen slot size: .006 inches Setting depth: From 470 feet to 550 feet

Type of completion (circle all applicable): Gravel packed Underreamed Telescoped Open hole Natural Development


Other (describe): _____

Top of lap pipe or reduction in casing: 260 feet. *If telescoped or more than one screen, describe on next page*

RECEIVED
 NOV 14 2007
 BY OLWR

The sketch below only required for water wells

If well telescopes, show depths on sketch.

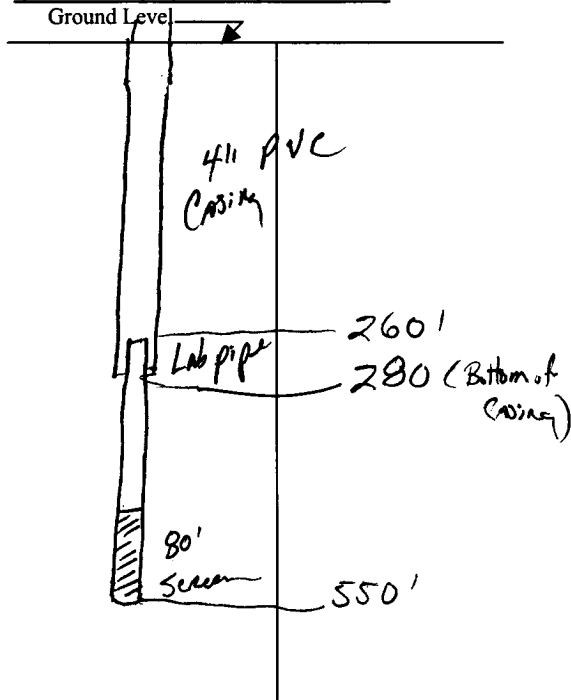


Description of formations encountered must be provided for all wells and boreholes, unless specifically exempted by regulations

Description of Formations Encountered	From (depth) To (depth)	
	Ground Level	
Clay	"	20'
White Sand	20	30'
Clay	30	70'
Fine Sand	70	105'
Clay	105	115'
Fine Sand/Lignite/clay	115	250'
Clay Rocks	250	300'
Fine Sand	300	375'
Fine/Coarse Sand	375	550'

If more than one screen, show location of each on sketch

Sketch the property layout and include the following: 1) the well location; 2) any permanent structures on the property that may aid in locating the well; 3) any roads, power lines, or other items that may aid in locating the property and the well; 4) a north arrow.

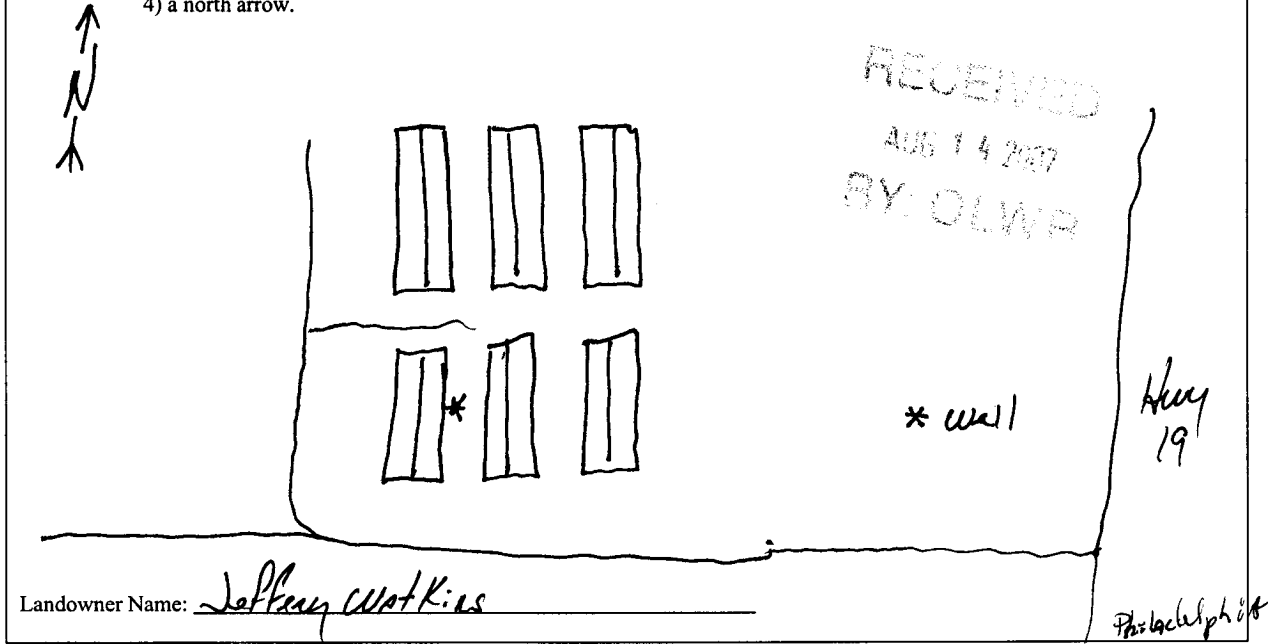

Form: OLWR-SWR-1A

I certify that the well/borehole was drilled, constructed, and completed in accordance with all applicable requirements of the Mississippi Department of Environmental Quality and the Mississippi Department of Health regulations, if applicable, and state laws.

Robert Anthony 0-284
 Print Name of Responsible Licensee and License No.

3/1/07
 Date

Robert Anthony
 Signature of Licensee

STATE WELL REPORT

Part 2

Pump Installer's Completion Report
 Mississippi Department of Environmental Quality
 Office of Land and Water Resources
 P.O. Box 10631
 Jackson, MS 39289-0631
 (601)961-5210
 (601)354-6938 (fax)

County: Neshoba
 Permit #: _____
 Driller: Robert Anthony
 Date completed: 12/2/06
Copy information from block on Part 1

For Office Use Only:

Aquifer: _____
 Well #: F-60
 Elevation: _____

This part of the report must be completed by a licensed water well contractor or a licensed pump installer. A copy of Part 1 of the report must be attached and both parts filed with the Department at the above address within 30 days of well completion.

Well Owner Information	Well Location
Owner Name: <u>Jeffrey Watkins</u>	Latitude: _____ Longitude: _____
Mailing Address: <u>12720 Hwy 16 E</u>	Method of Lat/Long (check one): Conventional Survey _____
<u>Philadelphia MS 39350</u>	USGS quad _____, Hand-held GPS _____, Survey-grade GPS _____
City State Zip Code	<u>SE 1/4 SW 1/4 Sec 12 T 11N R 11E</u>
Telephone No. <u>(601) 656-6837</u>	Distance Direction Nearest Town
	<u>3.5 Miles NW of Philadelphia</u>

Pump Type Circle one	Power Type Circle one
Air Lift Jet <input checked="" type="radio"/> <u>Submersible</u>	Diesel Engine Gasoline Engine Natural Gas
Bucket Piston Turbine	<input checked="" type="radio"/> <u>Electric Motor</u> Hand Tractor PTO
Centrifugal Rotary Flowing Well	Windmill Other (specify): _____
Other (specify): _____	Horse Power Rating of Motor: <u>5.0</u>
Date Pump Installed: <u>12/2/06</u>	Setting Depth: <u>150</u> feet
Rated Pump Capacity: <u>50</u> Gallons Per Minute	Number of Stages: <u>15</u>

Pump Test Data	Method of Measuring Water Level Circle one
Date Well Tested: <u>11/26/06</u>	Air Line <input checked="" type="radio"/> <u>Electric Measuring Line</u> Steel Tape
Static Water Level (A): <u>15</u> Feet Below Land Surface	Other (specify): _____
Pumping Water Level (B): <u>45</u> Feet Below Land Surface	For flowing well, measured shut in head: _____ feet
Drawdown [(B) - (A)]: <u>30</u> Feet Below Land Surface	Well yielded <u>70</u> GPM with a drawdown of
Test Pumping Rate: <u>75</u> Gallons Per Minute	<u>30</u> feet after <u>24</u> hours of pumping
Duration of Pump Test (minimum 4 hours): <u>6</u> hours	

I HEREBY CERTIFY that the above statements are true to the best of my knowledge.

Robert Anthony 0-284 Robert Anthony
 Print Name of Pump Installer and License No. (if applicable) Signature of Pump Installer

Form: OLWR-SWR-1B

AUG 14 2007
 BY: OLWR