

E 61  
NESHOPA  
6-26-73

MISSISSIPPI  
BOARD OF WATER COMMISSIONERS  
416 North State Street  
Jackson, Mississippi 39201

WATER WELL DRILLERS LOG

**CODED**

6-26 1973 Beck Smith Neshoba  
date well completed firm name county well located

LANDOWNER: Maggie Starr

description of formations encountered

from to

Phila, Miss.  
(mailing address)

red clay	0	30
rock	30	90
gray sand	90	130

WELL LOCATION:

sec. 5 T. 11 N R. 10 E  
7 miles west of Phila  
(distance) (direction) (nearest town)

WELL PURPOSE: home  
(home, irrigation, municipal, industrial)

**CODED**

WELL COMPLETION DATA:

- (1) diameter (inches) 2"
- (2) total depth (feet) 130"
- (3) static water level (feet) 80 (below above top of ground.)
- (4) casing galv. 125' (material) (depth)  
2" (size) If telescope see back.
- (5) screen 5' 125' (length) (depth to top)  
#008 stainless steel (size) (material)
- (6) pump 1 HP (HP) (yield gpm)  
elec. (type power)
- (7) electric log (yes or no)

(organization running log)


(8) how well bottom plugged back  
wash valve

DRILLERS REMARKS:

AUG 23 1973

If well telescopes please sketch and show depths.

GROUND LEVEL

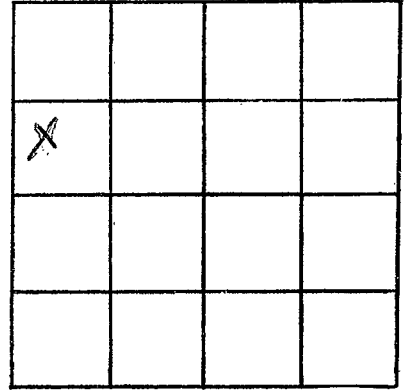

SECTION 5

Please indicate well location X.

ADDITIONAL INFORMATION

If more than one screen,  
show locations of each on sketch.