

**NESTHOBA**  
**E63**  
**10-30-74**

MISSISSIPPI  
 BOARD OF WATER COMMISSIONERS  
 416 North State Street  
 Jackson, Mississippi 39201

WATER WELL DRILLERS LOG

CODED

10-30-74 19 F.D. Camacho NESTHOBA  
 date well completed firm name county well located

LANDOWNER	description of formations encountered	from	to
<u>Mr. Roy Williams</u>	<u>philadelphia sand clay</u>	<u>0</u>	<u>18</u>
<u>R#7</u>	<u>hard clay</u>	<u>18</u>	<u>35</u>

(mailing address)

WELL LOCATION:

sec. 31 N R10 E  
2 miles S of Spive Hill  
 (distance) (direction) (nearest town)

WELL PURPOSE:

(home)  Irrigation, municipal, industrial)

WELL COMPLETION DATA:


- (1) diameter (inches) 2"
- (2) total depth (feet) 35
- (3) static water level (feet) 32 below above top of ground.
- (4) casing 2" P.V.C.  
 (material) (depth)  
2" if telescope see back.  
 (size)
- (5) screen 3" P.V.C. 29'  
 (length) (depth to top)  
3" P.V.C. 61'  
 (size) (material)
- (6) pump 1/2 115  
 (HP) (yield gpm)  
E. Lec.  
 (type power)
- (7) electric log NO  
 (yes or no)  
P.V.C.  
 (organization running log)
- (8) how well bottom plugged \_\_\_\_\_

DRILLERS REMARKS:

NOV - 4 1974  
 MISS. Bd. OF WATER COMM.

If well telescopes please sketch and show depths.

GROUND LEVEL

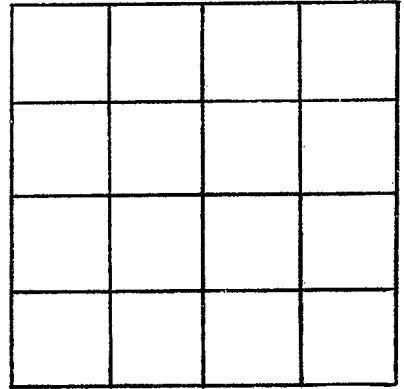

SECTION \_\_\_\_\_

Please indicate well location X.

ADDITIONAL INFORMATION

If more than one screen,  
show locations of each on sketch.