

NESHOBA

CODED

~~LEAKE~~
E 64
4/75

MISSISSIPPI
BOARD OF WATER COMMISSIONERS
416 North State Street
Jackson, Mississippi 39201

WATER WELL DRILLERS LOG

NESHOBA

April 1975 ¹⁴⁷ Thomas ~~Leake~~ firm name county well located

LANDOWNER: Ross Johnson

description of formations encountered	from	to
P. T	0	12
CHALK	12	18
COURSE SAND	18	25

Edinburg, Miss.
(mailing address)

WELL LOCATION:


sec. 6 T-11N R-10E
3 miles NE of Edinburg
(distance) (direction) (nearest town)

WELL PURPOSE:

(home, irrigation, municipal, industrial)

WELL COMPLETION DATA:

- (1) diameter (inches) 1 1/4
- (2) total depth (feet) 25
- (3) static water level (feet) 8 below above top of ground
- (4) casing 1 1/4 20
(material) (depth)
1 1/4 if telescope see back.
(size)
- (5) screen 5 20
(length) (depth to top)
2" 1/2 3/8 slot
(size) (material)
- (6) pump 1/3 6
(HP) (yield gpm)
Elec
(type power)
- (7) electric log No
(yes or no)
- (organization running log)
- (8) how well bottom plugged Point

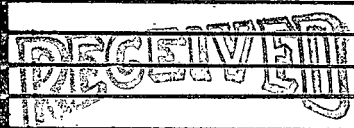


MAY 15 1975

DRILLERS REMARKS:

If well telescopes please sketch and show depths.

GROUND LEVEL

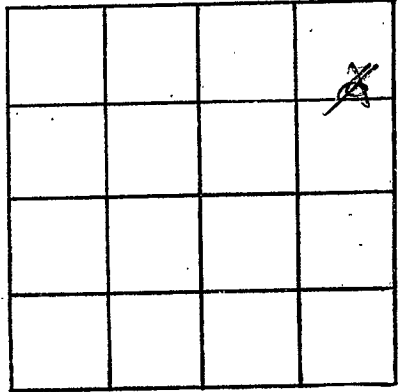

SECTION 6

Please indicate well location X.

ADDITIONAL INFORMATION

If more than one screen, show locations of each on sketch.