

Neshoba
E 200
11-24-75


13T

MISSISSIPPI
 BOARD OF WATER COMMISSIONERS
 416 North State Street
 Jackson, Mississippi 39201

WATER WELL DRILLERS LOG

Nov 24 1975 Thomas & Son Neshoba
 date well completed firm name county well located

LANDOWNER: <u>Jack Chevrolet</u> <u>Edingburg, Miss.</u>	description of formations encountered	from	to
(mailing address)			
WELL LOCATION: sec. <u>18</u> T. <u>11</u> N. R. <u>10</u> E <u>2</u> miles <u>E</u> of <u>Edingburg</u> (distance) (direction) (nearest town)	<u>Back shot - chalk</u> <u>course sand</u>	<u>0</u> <u>18</u>	<u>18</u> <u>25</u>
WELL PURPOSE: <u>CAMP House</u> (home, irrigation, municipal, industrial)			
WELL COMPLETION DATA:			
(1) diameter (inches) <u>2</u>			
(2) total depth (feet) <u>25</u>			
(3) static water level (feet) <u>18</u> <u>below</u> top of ground.			
(4) casing <u>12</u> <u>20</u> (material) (depth)			
<u>2</u> If telescope see back. (size)			
(5) screen <u>5</u> <u>20</u> (length) (depth to top)			
(6) pump <u>1/3</u> <u>7</u> (HP) (yield gpm)			
<u>elec</u> (type power)			
(7) electric log <u>no</u> (yes or no)			
(organization running log)			
(8) how well bottom plugged <u>part</u>			
DRILLERS REMARKS:			

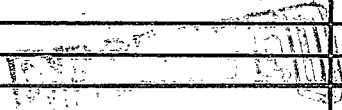

DEC 1 1975

MISS. BD. OF WATER COMMISSIONERS

If well telescopes, please sketch and show depths.

GROUND LEVEL

X			

SECTION 18

Please indicate well location X.

ADDITIONAL INFORMATION

If more than one screen, show locations of each on sketch.