

NESHOBAMA
 E 2001
 11/78

MISSISSIPPI
 BOARD OF WATER COMMISSIONERS
 416 North State Street
 Jackson, Mississippi 39201

WATER WELL DRILLERS LOG

Nov-1978 date well completed
 Thomas & Son firm name
 Neshoba county well located

LANDOWNER: Mrs. Jessie Tucker
 Edingburg, Miss.
 (mailing address)

description of formations encountered	from	to
Dirt	0	8
SLATE ROCK	8	14
Blue CHALK	14	40
SLATE ROCK & CHALK	40	85
FINE SAND STRS & CHALK	85	95
Coarse SAND w/ some HARD STR. CHALK	95	108

WELL LOCATION:
 sec. 7 T. 11N R. 10E
 10 1/2 miles NW of Phila.
 (distance) (direction) (nearest town)

WELL PURPOSE: Home
 (Home, Irrigation, municipal, industrial)

WELL COMPLETION DATA:

(1) diameter (inches) 2"
 (2) total depth (feet) 108
 (3) static water level (feet) 55 below top of ground
 (4) casing (material) (depth) 98
 2 (size) If telescope see back.
 (5) screen (length) (depth to top) 10 98
 2" slot (size) (material) Per
 (6) pump (HP) (yield gpm) 1 8
 Elec. (type power)
 (7) electric log No (yes or no)
 (organization running log)


DRILLERS REMARKS:
 Point

RECEIVED
 APR 3 1978

MISS. BD. OF WATER COMM.

If well telescopes please sketch and show depths.

GROUND LEVEL

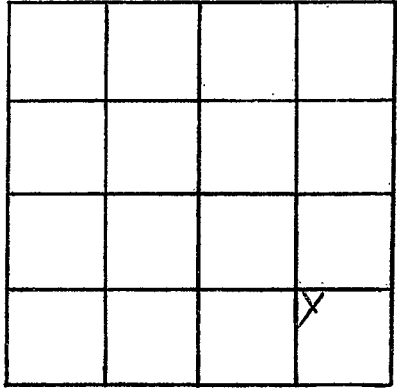

SECTION 2

Please indicate well location X.

ADDITIONAL INFORMATION

If more than one screen, show locations of each on sketch.