

NE SHOBA

E 2002

6/30/79

MISSISSIPPI BOARD OF WATER COMMISSIONERS 416 North State Street Jackson, Mississippi 39201

WATER WELL DRILLERS LOG

June 30 1979 Beck Smith Neshoba
Date well completed firm name county well located

LANDOWNER: Calvin Kittrell, Phila, Miss (mailing address)
description of formations encountered: red clay, blue clay, gray sand
from to: 0 28, 28 105, 105 148

WELL LOCATION: sec. 1 T 11 N R 10 W
4 1/2 miles W of Phila
(distance) (direction) (nearest town)

WELL PURPOSE: home
(home, irrigation, municipal, industrial)

- WELL COMPLETION DATA:
(1) diameter (inches) 2"
(2) total depth (feet) 148
(3) static water level (feet) 46 below top of ground.
(4) casing PVC, 138' (material) (depth)
2" (size) If telescope see back.
(5) screen 10' 138' (length) (depth to top)
008" PVC (size) (material)
(6) pump 1HP 6 (HP) (yield gpm)
elec (type power)
(7) electric log no (yes or no)
(organization running log)
(8) how well bottom plugged

Miss. Board of Water Comm.


AUG 16 1979

RECEIVED

DRILLERS REMARKS:

If well telescopes please sketch and show depths.

GROUND LEVEL

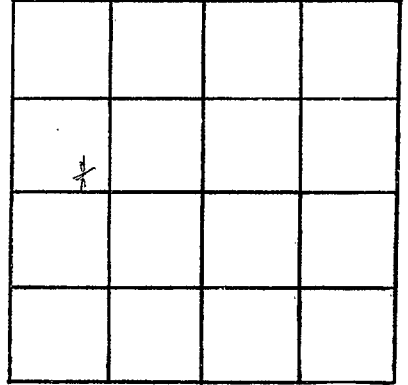

SECTION _____

Please indicate well location X.

ADDITIONAL INFORMATION

If more than one screen, show locations of each on sketch.