

NE SHOBA

E 2003

7/03/79

MISSISSIPPI BOARD OF WATER COMMISSIONERS  
416 North State Street  
Jackson, Mississippi 39201

WATER WELL DRILLERS LOG

7-3

1979 Beech Smith

Neshoba

date well completed

firm name

county well located

LANDOWNER:

Barron Posey  
Phila, Miss  
(mailing address)

description of formations encountered

red clay  
blue chert  
sand

from	to
0	30
30	66
66	98

WELL LOCATION:

sec. 1 T 11 N R 10 E  
S W  
4 1/2 miles W of Phila  
(distance) (direction) (nearest town)

WELL PURPOSE:

home  
(home, irrigation, municipal, industrial)

WELL COMPLETION DATA:

- (1) diameter (inches) 2"
- (2) total depth (feet) 98'
- (3) static water level (feet) 58' below above top of ground.
- (4) casing PVC 88' (material) (depth)  
2" (size) if telescope see back.
- (5) screen 10' 88' (length) (depth to top)  
008 (size) PVC (material)
- (6) pump 1 HP 6 (HP) (yield gpm)  
elec (type power)
- (7) electric log No (yes or no)

(organization running log)

- (8) how well bottom plugged

DRILLERS REMARKS:


Miss. Board of Water Comm.

AUG 10 1979

RECEIVED

If well telescopes please sketch and show depths.

GROUND LEVEL

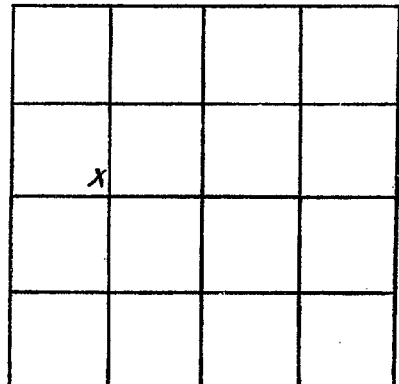

SECTION \_\_\_\_\_

Please indicate well location X.

ADDITIONAL INFORMATION

A series of 18 horizontal lines for writing additional information.

If more than one screen, show locations of each on sketch.