

Neshoba  
E 2004  
8-4-81

MISSISSIPPI  
 BOARD OF WATER COMMISSIONERS  
 416 North State Street  
 Jackson, Mississippi 39201

WATER WELL DRILLERS LOG

8-4 1981 Thomas Neshoba  
 date well completed firm name county well located

LANDOWNER: DAVID Hollis  
Edinburgh  
 (mailing address)

description of formations encountered	from	to
DIRTY SAND	0	18
CHALK	18	26
SLATE ROCK HARD	26	72
CHALK	72	75
COURSE SAND	75	85
FINE SAND	85	97

WELL LOCATION:  
 sec. 18 T. 11 S. R. 10 E  
11 miles NW of Ph. W.  
 (distance) (direction) (nearest town)

WELL PURPOSE: CHICKEN  
 (home, irrigation, municipal, industrial)

- WELL COMPLETION DATA:
- (1) diameter (inches) 4
  - (2) total depth (feet) 97
  - (3) static water level (feet) 50 below top of ground.
  - (4) casing PVC 77  
 (material) (depth)  
4 if telescope see back.  
 (size)
  - (5) screen 20 77  
 (length) (depth to top)  
4" 10510 PVC  
 (size) (material)
  - (6) pump 34 18  
 (HP) (yield gpm)  
E1e1  
 (type power)
  - (7) electric log NO  
 (yes or no)
  - (organization running log)
  - (8) how well bottom plugged Point

DEPT. OF NATURAL RESOURCES  
 BUREAU OF LAND & WATER RESOURCES


OCT - 9 1981

RECEIVED

DRILLERS REMARKS:

If well telescopes please sketch and show depths.

GROUND LEVEL

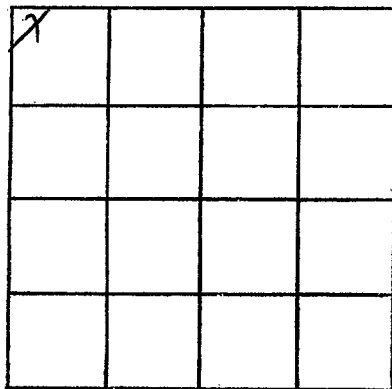

SECTION 18

Please indicate well location X.

ADDITIONAL INFORMATION

Lined area for additional information.

If more than one screen, show locations of each on sketch.