

MISSISSIPPI DEPARTMENT OF NATURAL RESOURCES

Bureau of Land and Water Resources

Southport Mall

P.O. Box 10631

Jackson, Mississippi 39209

WATER WELL DRILLERS LOG

Neshoba
E
206

4-29 1983 F.D. Cannon NESTLE
 (date well completed) (firm name) (county well located)

LANDOWNER: Copper
Thomson
 (mailing address)

description of formations encountered	from	to
<u>Red Clay</u>	<u>0</u>	<u>42</u>
<u>Green sand</u>	<u>42</u>	<u>105</u>
<u>Sand</u>	<u>105</u>	<u>110</u>
<u>Black sand</u>	<u>110</u>	<u>126</u>
<u>Sand</u>	<u>126</u>	<u>142</u>
<u>Black sand</u>	<u>142</u>	<u>169</u>
<u>Cold Sand</u>	<u>169</u>	<u>169</u>
<u>Blue Blue</u>	<u>169</u>	<u>252</u>
<u>Block. Gary</u>	<u>252</u>	<u>252</u>

WELL LOCATION:
 sec 7 Q110 Q100
1 1/2 miles NE of Edinburg
 (distance) (direction) (nearest town)

WELL PURPOSE:
 (home) irrigation, municipal, industrial

- WELL COMPLETION DATA:
- (1) diameter (inches) 2"
 - (2) total depth (feet) 169'
 - (3) static water level (feet) 100' below above top of ground.
 - (4) casing 2" 169'
 (material) (depth)
2" If telescope see back.
 (size)
 - (5) screen 2" P.V.C. 150
 (length) (depth to top)
2" x 15" pvc pipe
 (size) (material)
 - (6) pump 1 220
 (HP) (yield gpm)
Elec.
 (type power)
 - (7) electric log NO
 (yes or no)
Cap
 (organization running log)
 - (8) how well bottom plugged _____

DRILLERS REMARKS:


DEPT. OF NATURAL RESOURCES
 BUREAU OF LAND & WATER RESOURCES

MAY 2 - 1983

RECEIVED

If well telescopes please sketch and show depths.

GROUND LEVEL

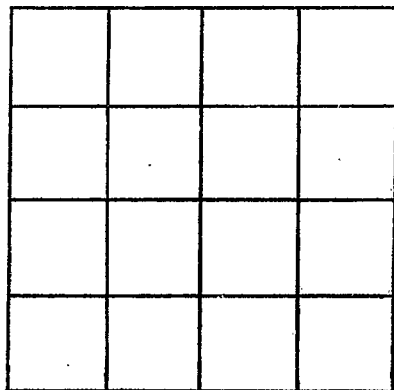

SECTION _____

Please indicate well location X.

ADDITIONAL INFORMATION

If more than one screen,
show locations of each on sketch.