

MISSISSIPPI DEPARTMENT OF NATURAL RESOURCES

Bureau of Land and Water Resources

Southport Mall

P.O. Box 10631

Jackson, Mississippi 39209

WATER WELL DRILLERS LOG

Neshoba
E 2007

2-2 1983 F.O. Cannon NESHOBIA
 date well completed firm name county well located

LANDOWNER: <u>Suhine Willis</u>	description of formations encountered	from	to
<u>R# 7 Box 26 PLIA</u>	<u>MS Red clay</u>	<u>0</u>	<u>20</u>
	<u>pink sand</u>	<u>20</u>	<u>40</u>
	<u>Beleh diene</u>	<u>40</u>	<u>140</u>
	<u>gray sand</u>	<u>140</u>	<u>160</u>
	<u>black diene</u>	<u>160</u>	<u>200</u>
	<u>black</u>	<u>200</u>	<u>210</u>
	<u>Green zone</u>	<u>210</u>	<u>230</u>
	<u>gray sand</u>	<u>230</u>	<u>263</u>

WELL LOCATION:
 sec. 24 T 11 N S R 10 E W
7 miles W of PLIA
 (distance) (direction) (nearest town)

WELL PURPOSE:
 (home) Irrigation, municipal, industrial

WELL COMPLETION DATA:

(1) diameter (inches) 2"

(2) total depth (feet) 263'

(3) static water level (feet) 200' below above top of ground.

(4) casing 2" 263'
 (material) (depth)

2"
 (size) If telescope see back.

(5) screen 2" pvc 180'
 (length) (depth to top)

2x4" Stielcut
 (size) (material)

(6) pump 1 220
 (HP) (yield gpm)

Elec.
 (type power)

(7) electric log NO
 (yes or no)

open
 (organization running log)

(8) how well bottom plugged

DEPT. OF NATURAL RESOURCES
 BUREAU OF LAND & WATER RESOURCES


JUN - 6 1983

RECEIVED

DRILLERS REMARKS:

If well telescopes please
sketch and show depths.

GROUND LEVEL

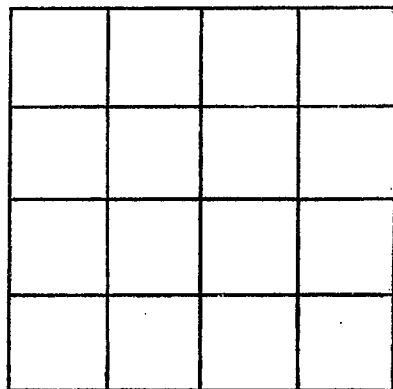

SECTION _____

Please indicate well location X.

ADDITIONAL INFORMATION

If more than one screen,
show locations of each on sketch.