

MISSISSIPPI DEPARTMENT OF NATURAL RESOURCES

Bureau of Land and Water Resources

Southport Mall

P.O. Box 10631

Jackson, Mississippi 39209

WATER WELL DRILLERS LOG

Neshoba
E 2008

11-7 1984 THOMAS & SON Neshoba
 date well completed firm name county well located

LANDOWNER:	description of formations encountered	from	to
<u>JAMES TUCKER</u> (owner)	<u>Red sand</u>	<u>0</u>	<u>16</u>
	<u>Grey chalk</u>	<u>16</u>	<u>56</u>
<u>CARTHAGE MS</u> (mailing address)	<u>White c. sand</u>	<u>56</u>	<u>103</u>

WELL LOCATION:
 sec. 2 T. 11 N. R. 10 E.
3 miles S of Edwards
 (distance) (direction) (nearest town)

WELL PURPOSE:
 (home, irrigation, municipal, industrial)

- WELL COMPLETION DATA:
- (1) diameter (inches) 2"
 - (2) total depth (feet) 103'
 - (3) static water level (feet) 34' below above top of ground.
 - (4) casing PVC, 103'
 (material) (depth)
2" if telescope see back.
 (size)
 - (5) screen 10', 93'
 (length) (depth to top)
2" PVC
 (size) (material)
 - (6) pump 1, 8
 (HP) (yield gpm)
Electric
 (type power)
 - (7) electric log NTD
 (yes or no)
- (organization running log)
- (8) how well bottom plugged Sanded

DRILLERS REMARKS:


DEPT. OF NATURAL RESOURCES
 BUREAU OF LAND & WATER RESOURCES

DEC 21 1984

RECEIVED

If well telescopes please sketch and show depths.

GROUND LEVEL

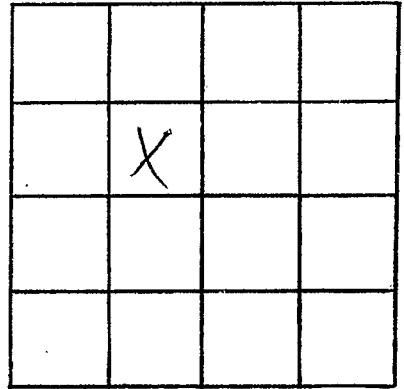

SECTION _____

Please indicate well location X.

ADDITIONAL INFORMATION

If more than one screen,
show locations of each on sketch.