

MISSISSIPPI DEPARTMENT OF NATURAL RESOURCES
Bureau of Land and Water Resources
 Southport Mall
 P.O. Box 10631
 Jackson, Mississippi 39209
WATER WELL DRILLERS LOG

Neshoba
E 2009

3-24 19 86 Smith's well Drilling Neshoba
 date well completed firm name county well located

LANDOWNER: Larry Heath

description of formations encountered

from to

(mailing address)

<u>Red clay</u>	<u>0</u>	<u>22</u>
<u>Blue chalk & Rock</u>	<u>22</u>	<u>80</u>
<u>White sand</u>	<u>80</u>	<u>95</u>

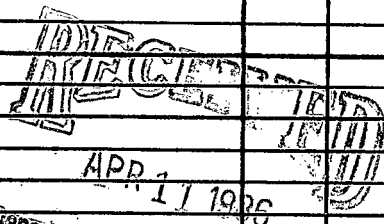
WELL LOCATION:

sec. 8 T. 11 N R. 10 E
13 miles W of Phila
 (distance) (direction) (nearest town)

WELL PURPOSE: Home
 (home, irrigation, municipal, industrial)

WELL COMPLETION DATA:

- diameter (inches) 2 1/2
- total depth (feet) 95 FT
- static water level (feet) 65 FT below above top of ground.
- casing PVC, 85 FT
 (material) (depth)
 (size) if telescope see back.
- screen 10 FT, 85 FT
 (length) (depth to top)
2 1/2, PVC
 (size) (material)
- pump 1 1/2, 8
 (HP) (yield gpm)
E
 (type power)
- electric log no
 (yes or no)
 (organization running log)
- how well bottom plugged _____

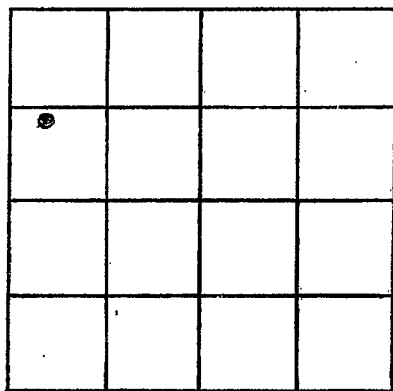

 APR 11 1986

DRILLERS REMARKS:

Department of Natural Resources
 Bureau of Land and Water Resources

If well telescopes please sketch and show depths.

GROUND LEVEL



SECTION _____

Please indicate well location X.

ADDITIONAL INFORMATION

If more than one screen,
show locations of each on sketch.