

NESHUBA  
E 2010

MISSISSIPPI DEPARTMENT OF NATURAL RESOURCES  
 Bureau of Land and Water Resources  
 Southport Mall  
 P.O. Box 10631  
 Jackson, Mississippi 39209  
**WATER WELL DRILLERS LOG**

8-31- 1989 F. D. Lowery NESHUBA  
 date well completed firm name county well located


LANDOWNER: ~~Stanley~~ T. O. Thompson  
Stanley  
 (mailing address)

Description of formations encountered	from	to
	<u>Red clay</u>	<u>0</u>
<u>Sand</u>	<u>12</u>	<u>20</u>
<u>Rock</u>	<u>20</u>	<u>80</u>
<u>Red clay</u>	<u>80</u>	<u>100</u>
<u>Clay sand</u>	<u>100</u>	<u>126</u>

WELL LOCATION:  
 sec. 7 11 N 10 E  
S W  
13 miles E of CANT stage  
 (distance) (direction) (nearest town)

WELL PURPOSE:  
 home irrigation, municipal, industrial

- WELL COMPLETION DATA:
- (1) diameter (inches) 2 1/2
  - (2) total depth (feet) 126'
  - (3) static water level (feet) 98' below top of ground.
  - (4) casing 2 1/2" 126'  
 (material) (depth)
  - 2 1/2" if telescope see back.  
 (size)
  - (5) screen 2 1/2" 126'  
 (length) (depth to top)
  - 2" x 10' pipe  
 (size) (material)
  - (6) pump 5 220  
 (HP) (yield gpm)
  - Elec.  
 (type power)
  - (7) electric log NO  
 (yes or no)
  - Sand Island  
 (organization running log)
  - (8) how well bottom plugged \_\_\_\_\_

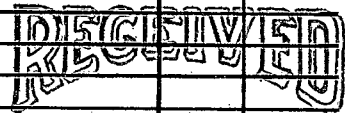


SEP 5 1989

Department of Natural Resources  
 Bureau of Land and Water Resources

DRILLERS REMARKS:

If well telescopes please  
sketch and show depths.

GROUND LEVEL

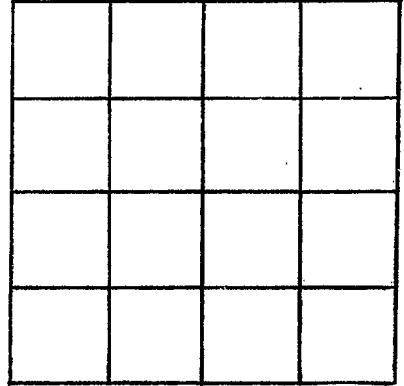

SECTION \_\_\_\_\_

Please indicate well location X.

ADDITIONAL INFORMATION

If more than one screen,  
show locations of each on sketch.