

WATER WELL DRILLERS LOG

Date: 7-29, 1960, Driller: Water Ogletree County: Neshoba

(1) Owner of Land: Greenwell Methodist Church (Name)
(2) Location: Rt 7 Philadelphia (Address)
(3) Topography: Valley (Hilly) (Flat) (Level)
(4) Purpose of Well: Home use (Domestic Irrigation Municipal, Industrial, Other)


Table with 3 columns: Description & Color of Materials, Thickness Feet, Depth Feet. Contains handwritten entry: Red clay sand.

Information upon completion of well:

(1) Diameter 6 1/2 inches.
(2) Total Depth 74 feet.
(3) Water Level 60 feet below top of ground.
(4) Cased to 48, Size
(5) Screen: Size 1 1/2, Length 60
(6) Were any formations sealed against pollution?
yes, no.

If YES depth of formation
Why

Drillers Remarks:

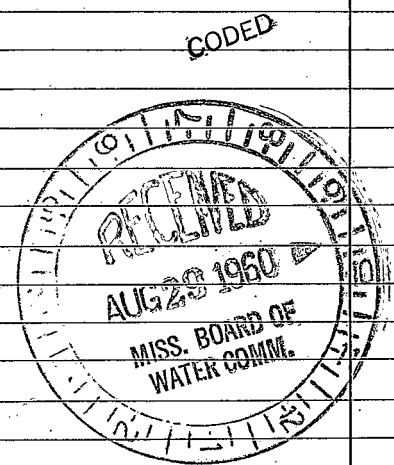

(Use Back Side)

Well No.

