

Neshoba
OFIO
10-65

MISSISSIPPI BOARD OF WATER COMMISSIONERS

3 131

WATER WELL DRILLERS LOG

ELOG #16
CODED

Date: 10/15/65, 1965, Driller: TERRY County: NESHOPA
Name

(1) Owner of Land: DEWEESE LBR Co
(Name)
Philadelphia, Miss.
(Address)

(2) Location: 1/4, 1/4, Sec. 36 T11 R11
1 miles South of Phila.
(distance) (direction) (Nearest Town)

(3) Topography: (Level)
(Hilly) (Flat)

(4) Purpose of Well: Industrial
(Domestic Irrigation
Municipal, Industrial, Other)

Description & Color of Materials Sand, Clay, Red Clay, Shell, etc.	Thick- ness Feet	Depth Feet
YELLOW CLAY & WHITE SAND	0	42'
GRAY SAND & SHALE	42	145'
SHALE	145	240
SANDY	240	360
SANDY SHALE	360	455'
" "	455	685'
SAND - COARSE	685	777'

Information upon completion of well:

(1) Diameter 6 inches.

(2) Total Depth 777 feet.

(3) Water Level 63' feet below top of ground.

(4) Cased to 420, Size 6"


(5) Screen: Size 4', Length 57'

(6) Were any formations sealed against pollution?
yes, no.

CODED

If YES depth of formation _____
Why _____

Drillers Remarks: IRON IN WATER
WELL pumps 365 gpm.

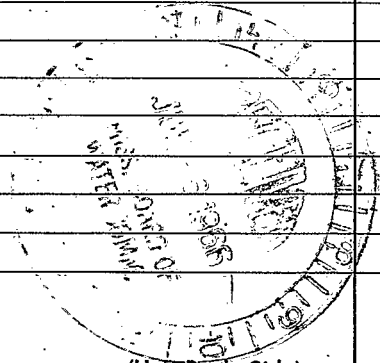

(Use Back Side)

Well No.

(K)