

F 12
9-66

3 13T

This hole el log #17
el log #19 to 1033
in F11

WATER WELL DRILLERS LOG

MS-6W-12644

Date: Sept. 19 66, Driller: Layne-Central Co. County Neshoba

Central w/a Kentawka (Name)

~~Kentawka Valley Water Association~~

(1) Owner of Land: (Name)

Philadelphia, Mississippi

(Address) 33 N 11

(2) Location: 1/4, SE 1/4, Sec. 17, T. 1 N. R. 1 E

3-1/2 miles South W of Philadelphia
(distance) (direction) (Nearest Town)

(3) Topography: (Hilly) (Flat) (Level)

(4) Purpose of Well: Domestic
(Domestic Irrigation, Municipal, Industrial, Other)

Description & Color of Materials Sand, Clay, Red Clay, Shell, etc.	Thick- ness Feet	Depth Feet
Clay	9	9
Rock, Stks. of Shale	36	45
Sand	47	92
Hard Shale	168	260
Shale, Stks. of Sand	146	406
Hard shale, stks. lignite	227	633
Sand & Shale	13	646
Rock	1	647
Hard Shale, Stks. of sand	41	688
Sand	42	730
Gummy Shale	18	748

Information upon completion of well:

(1) Diameter 10 inches.

(2) Total Depth 735 feet.

(3) Water Level 142 feet below top of ground.

(4) Cased to 687', Size 10"

(5) Screen: Size 6", Length 40 ft.



(6) Were any formations sealed against pollution?
_____ yes, _____ no.

If YES depth of formation _____

Why _____

Drillers Remarks:

Test hole by
Newdow-Nomas

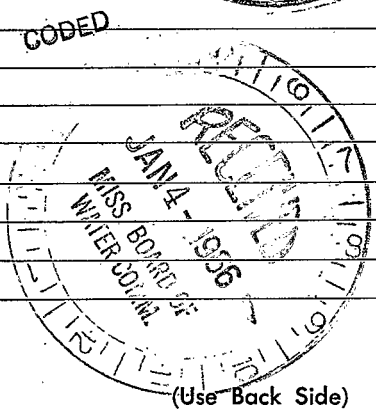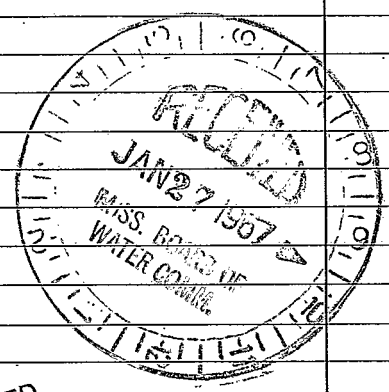

(Use Back Side)

Well No.

(A)

Handwritten header text, possibly including a date or page number.

Handwritten text, possibly a title or subject line.

Handwritten text, possibly a name or address.

Main body of handwritten text, appearing to be a list or series of entries.

Handwritten text, possibly a signature or a note.

Handwritten text, possibly a date or a specific reference.

Handwritten text at the bottom of the page.