

3 13

Neshoba  
713  
1-67

MISSISSIPPI  
BOARD OF WATER COMMISSIONERS  
416 North State Street  
JACKSON, MISSISSIPPI 39201

WATER WELL DRILLERS LOG

January 31 19 67 Ogletree Drilling Neshoba  
date well completed firm name county well located

LANDOWNER: Gary O. Watkins

description of formations encountered	from	to
	Red Clay	0
White Chalk	10	40
Blue Clay	40	70
Gray Sand	70	120

Route 8  
Philadelphia, Miss.  
(mailing address)


WELL LOCATION:  
sec. 11 T. 11 N. R. 11 E.  
S. W.  
4 miles North Phila.  
(distance) (direction) (nearest town)

WELL PURPOSE: Home use  
(home, irrigation, municipal, industrial)

WELL COMPLETION DATA:

- (1) diameter (inches) 2"
- (2) total depth (feet) 120ft.
- (3) static water level (feet) 42 below above top of ground.
- (4) casing Gav. 63  
(material) (depth)  
         if telescope see back.  
(size)
- (5) screen None  
(length) (depth to top)  
         (size) (material)
- (6) pump 1/2 7  
(HP) (yield gpm)  
         (type power)
- (7) electric log           
(yes or no)  
         (organization running log)
- (8) how well bottom plugged


CODED

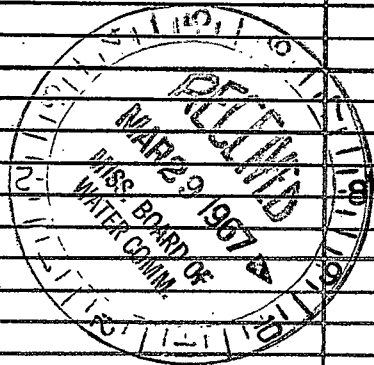

DRILLERS REMARKS:

If well telescopes please sketch and show depths.

GROUND LEVEL

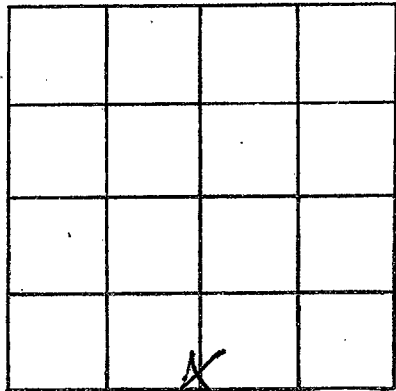

SECTION 11

Please indicate well location X.

ADDITIONAL INFORMATION

If more than one screen, show locations of each on sketch.