

3 131

Neshoba
714
2-67 CODED

MISSISSIPPI
BOARD OF WATER COMMISSIONERS
416 North State Street
Jackson, Mississippi 39201
WATER WELL DRILLERS LOG

February 23 19 67 Ogletree Drilling Neshoba
date well completed firm name county well located

LANDOWNER: James H. Kirkland

description of formations encountered	from	to
Red Clay	0	18
Blue Chalk	18	160
Gray Sand	160	180

Rt. 8, Philadelphia, Miss.
(mailing address)

WELL LOCATION:
sec. 15 T 11 N R 11 E
S. W
3 miles N. of Phila.
(distance) (direction) (nearest town)


WELL PURPOSE: Home use
(home, irrigation, municipal, industrial)

WELL COMPLETION DATA:

- (1) diameter (inches) 2"
- (2) total depth (feet) 180
- (3) static water level (feet) 45 below top of ground.
- (4) casing 2" (material), 105 (depth),
if telescope see back.
(size)
- (5) screen None (length), (depth to top)
(size), (material)
- (6) pump 3/4 (HP), 6.5 (yield gpm)
REA (type power)
- (7) electric log (yes or no)
(organization running log)
- (8) how well bottom plugged

CODED

DRILLERS REMARKS:

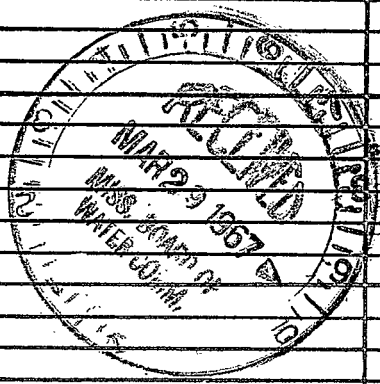

If well telescopes please sketch and show depths.

GROUND LEVEL

			X

SECTION 5

Please indicate well location X.

ADDITIONAL INFORMATION

If more than one screen, show locations of each on sketch.