

3 137

Neshoba
715
4-67 CODED

MISSISSIPPI
BOARD OF WATER COMMISSIONERS
416 North State Street
Jackson, Mississippi 39201
WATER WELL DRILLERS LOG

April 6 19 67 Ogletree Drilling Neshoba
date well completed firm name county well located


LANDOWNER: James Lee
Rt. 3
Philadelphia, Miss.
(mailing address)
WELL LOCATION:
sec. 13 T. 11 N. R. 11 E.
S W
2 miles N of Phil.
(distance) (direction) (nearest town)

description of formations encountered	from	to
	Red clay	0
Blue chalk	10	68
Blue Sand	68	95

WELL PURPOSE: Home use
(home, irrigation, municipal, industrial)

WELL COMPLETION DATA:
(1) diameter (inches) 2 1/2
(2) total depth (feet) 95
(3) static water level (feet) 40 below top of ground.
(4) casing Gay, 90' (material), (depth), 2" (size) if telescope see back.
(5) screen 5' (length), 90' (depth to top), 1 1/4" Stainless Steel (size), (material)
(6) pump 1/2 (HP), 6 (yield gpm), Elec (type power)
(7) electric log NO (yes or no), Ogletree Drilling (organization running log)
(8) how well bottom plugged Back Wash Valve

DRILLERS REMARKS:

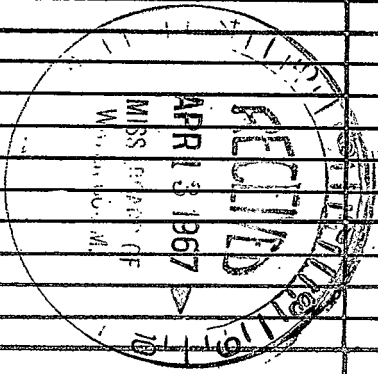

If well telescopes please sketch and show depths.

GROUND LEVEL

X			

SECTION 13

Please indicate well location X.

ADDITIONAL INFORMATION

If more than one screen, show locations of each on sketch.