

3 135

Neshoba

716

7-67

CODED

MISSISSIPPI
 BOARD OF WATER COMMISSIONERS
 416 North State Street
 Jackson, Mississippi 39201

WATER WELL DRILLERS LOG

JULY 31 19 67 OGLETREE DRILLING NESHOBA
 date well completed firm name county well located

LANDOWNER: PAUL WILLIAMSON

description of formations encountered	from	to
	RED CLAY	0
RED SAND	30	30
WHITE SAND	30	68

PT. 6

PHILADELPHIA, MISS (mailing address)


WELL LOCATION:
 sec. 24 T. 11 N. R. 11 E.
 C S W
 1 miles NORTH of PHILA.
 (distance) (direction) (nearest town)

WELL PURPOSE: HOME USE (home, irrigation, municipal, industrial)

- WELL COMPLETION DATA:
- (1) diameter (inches) 2"
 - (2) total depth (feet) 73
 - (3) static water level (feet) 25 below above top of ground.
 - (4) casing GAV. 68, (material) (depth)
 _____ if telescope see back.
 (size)
 - (5) screen 1 1/4 68
 (length) (depth to top)
1 1/4 STAINLESS STEEL
 (size) (material)
 - (6) pump 1/2 4.5
 (HP) (yield gpm)
REA
 (type power)
 - (7) electric log NO
 (yes or no)

 (organization running log)
 - (8) how well bottom plugged POINTED


CODED

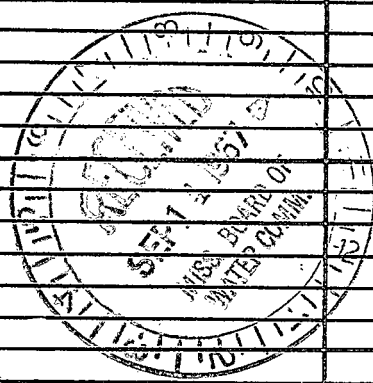

DRILLERS REMARKS:

If well telescopes please sketch and show depths.

GROUND LEVEL

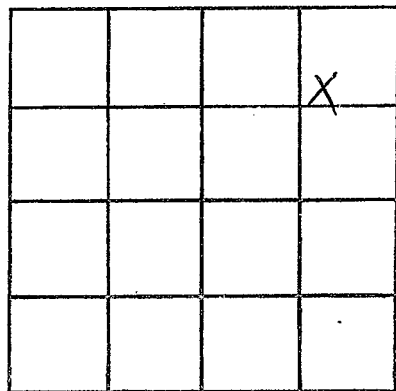

SECTION 24

Please indicate well location X.

ADDITIONAL INFORMATION

If more than one screen, show locations of each on sketch.