

NESHOBA

F 17  
4-2-61

131  
CODED

WATER WELL DRILLERS LOG

CODED

F 302

Date: 4-2-61, 1961, Driller: W. L. Ray, County: neshoba

(Name)

(1) Owner of Land: W. L. Ray  
 (Name)  
131 Neshoba  
 (Address)

(2) Location: 1/4, 1/4, Sec. 35 T11 R11  
at miles neshoba of  
 (distance) (direction) (Nearest Town)

(3) Topography:  Level  
 (Hilly) (Flat) (Level)

(4) Purpose of Well: Domestic  
 (Domestic Irrigation  
 Municipal, Industrial, Other)

Description & Color of Materials Sand, Clay, Red Clay, Shell, etc.	Thick- ness- Feet	Depth Feet
<u>Blue sand</u>		<u>20</u>
<u>pink sil</u>	<u>1</u>	<u>75</u>
<u>white sand</u>	<u>1</u>	<u>90</u>

Information upon completion of well:


- (1) Diameter 2 inches.
- (2) Total Depth 190 feet.
- (3) Water level 30 feet below top of ground.
- (4) Cased to 90, Size 2 in
- (5) Screen: Size open, Length well
- (6) Were any formations sealed against pollution?  
 yes,  no.

CODED

If YES depth of formation 20 ft

Why commercial

Drillers Remarks: 1 1/2 inches  
vertical well  
on north of 1530

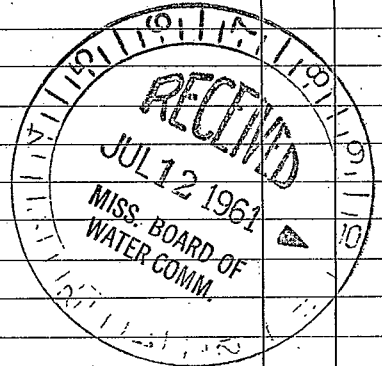

Well No.

(Use Back Side)

