

CODED

Neshoba
719
12-15-69

MISSISSIPPI
BOARD OF WATER COMMISSIONERS
416 North State Street
Jackson, Mississippi 39201

WATER WELL DRILLERS LOG

Dec 15 1969 Jerry Drilling Neshoba
date well completed firm name county well located

LANDOWNER:
Wyershamer Co.
Philadelphia, Miss.
(mailing address)

description of formations encountered	from	to
yellow clay	0	15
sand	15	30
Clay & sand	30	40
Clay	40	100
fine sand	100	150
Coarse sand	150	220
fine sand	220	350
Philadelphia shale	350	390
sandy	390	440
hard shale	440	550
shale & lignite	550	650
mixed	650	690
Coarse sand	690	748

WELL LOCATION:
sec. 36 T 11 N R 11 E
S W
1 miles SW of Philadelphia
(distance) (direction) (nearest town)

WELL PURPOSE:
(home, irrigation, municipal, industrial)

WELL COMPLETION DATA:

(1) diameter (inches) 6"

(2) total depth (feet) 748

(3) static water level (feet) 601 below above top of ground.

(4) casing BK 502'
(material) (depth)
4" if telescope see back.
(size)

(5) screen 50' 698
(length) (depth to top)
4" Stainless Steel
(size) (material)

(6) pump 25 390
(HP) (yield gpm)
turbine
(type power)

(7) electric log No
(yes or no)

(organization running log)

(8) how well bottom plugged
each side

JAN - 5 1970

MISS. Bd. of WATER COMMISSIONERS

DRILLERS REMARKS:
Very good well

(X)

If well telescopes please sketch and show depths.

GROUND LEVEL

502' - 6" Bak


lead seal 492'

4" pipe

555'
4" pipe

748' total depth

If more than one screen, show locations of each on sketch.

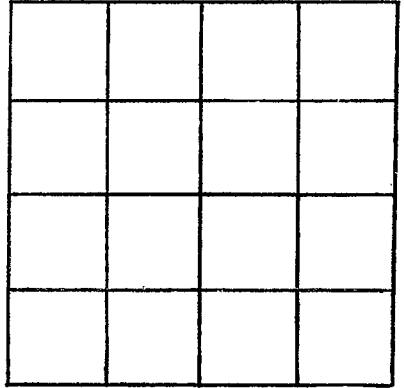

SECTION 36

Please indicate well location X.

ADDITIONAL INFORMATION

Lined area for additional information.