

**MISSISSIPPI
BOARD OF WATER COMMISSIONERS**
416 North State Street
Jackson, Mississippi 39201

CODE 1

CODE 2

WATER WELL DRILLERS LOG

<i>Neshoba Co</i>
<i>F 21</i>
<i>2-69</i>

2-7 19*69* *Agitation Drilling Co.* *Neshoba*
 date well completed firm name county well located

LANDOWNER:

Louis L. Tidwell

description of formations encountered

from to

Route 4 Phila. Miss.
(mailing address)

Red clay	0	30
<i>white sand</i>	30	45
<i>Blue chalk</i>	45	90
<i>Blue sand</i>	90	110
<i>Blue chalk</i>	110	595
<i>white sand</i>	595	651

WELL LOCATION:

sec. *6* T. *11* (N) R. *11* (E)
2 miles *South* of *Phila.*
 (distance) (direction) (nearest town)

WELL PURPOSE: *Home*
 (home, irrigation, municipal, industrial)

WELL COMPLETION DATA:

- (1) diameter (inches) *4*
- (2) total depth (feet) *651*
- (3) static water level (feet) *90* (below/above top of ground)
- (4) casing (material) *Steel*, (depth) *110*
 _____ If telescope see back.
 (size)
- (5) screen *none*, (length) _____, (depth to top) _____
 (size) _____ (material) _____
- (6) pump *1 1/2* (HP), *12.5* (yield gpm)
R.P.A. (type power)
- (7) electric log _____ (yes or no)
 _____ (organization running log)
- (8) how well bottom plugged *open*

MAR 3 1969

MISS. BD. OF
WATER COMM.


DRILLERS REMARKS:

If well telescopes please sketch and show depths.

GROUND LEVEL

41" Cassin
0-140

140-65/
open

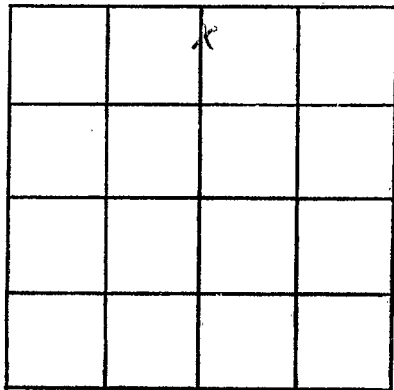

SECTION 6

Please indicate well location X.

ADDITIONAL INFORMATION

If more than one screen,
show locations of each on sketch.