

MISSISSIPPI  
BOARD OF WATER COMMISSIONERS  
416 North State Street  
Jackson, Mississippi 39201

WATER WELL DRILLERS LOG

Neshoba  
722  
8-27-69

8-27 1969 Cytheris Drilling Co. Neshoba  
date well completed firm name county well located

LANDOWNER:

Joe Sigrest  
P.O. 2 Phila. Miss  
(mailing address)

description of formations encountered

from to

<u>Red clay</u>	<u>0</u>	<u>20</u>
<u>Blue chalk</u>	<u>20</u>	<u>130</u>
<u>Gray sand</u>	<u>130</u>	<u>164</u>

WELL LOCATION:

sec. 24 T. 11 (N) R. 11 (E)  
1 miles North of Phila.  
(distance) (direction) (nearest town)

WELL PURPOSE: Hand well  
(home, irrigation, municipal, industrial)

WELL COMPLETION DATA:

- (1) diameter (inches) 3"
- (2) total depth (feet) 164'
- (3) static water level (feet) 80 <sup>below</sup> <sub>above</sub> top of ground.
- (4) casing Galv 154'  
(material) (depth)

         If telescope see back.  
(size)

- (5) screen 10 A. 164-154  
(length) (depth to top)
- 1/4 Stainless Steel  
(size) (material)

- (6) pump 1/2 5  
(HP) (yield gpm)

A Phila. W.  
(type power)

- (7) electric log           
(yes or no)

          
(organization running log)


- (8) how well bottom plugged Painted

DRILLERS REMARKS:

007 24  
MISS. DIV. OF  
WATER RESOURCES

If well telescopes please sketch and show depths.

GROUND LEVEL

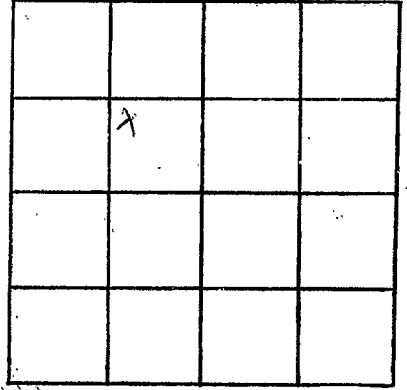

SECTION 24

Please indicate well location X.

ADDITIONAL INFORMATION

If more than one screen,  
show locations of each on sketch.