

NESHOBA

F 23

10-24-69

MISSISSIPPI
 BOARD OF WATER COMMISSIONERS
 416 North State Street
 Jackson, Mississippi 39201

CODED

WATER WELL DRILLERS LOG

10-24

19

69 Drilling Drilling Co

Neshoba

date well completed

firm name

county well located

LANDOWNER:

Burdett Richardson

Cibola Miss City
(mailing address)

description of formations encountered

from

to

Red Clay 0 14
 Blue Clay 14 100
 Blue + Sandstone 100 15

WELL LOCATION:

sec. 25 T. 11 N. R. 11 E.
 S. W.
 Cibola Miss City
 (distance) miles (direction) of (nearest town)

WELL PURPOSE:

none (home, irrigation, municipal, industrial)

WELL COMPLETION DATA:

- (1) diameter (inches) 2"
- (2) total depth (feet) 157
- (3) static water level (feet) 38 below top of ground.
- (4) casing Flow 147 (material) (depth)
- (size) If telescope see back.
- (5) screen 10 157-147 (length) (depth to top)
 1 1/2" Stainless steel (size) (material)
- (6) pump 1/2 5.6 (HP) (yield gpm)
 Cibola 1st. (type power)
- (7) electric log NO (yes or no)

(organization running log)


(8) how well bottom plugged

DRILLERS REMARKS:

NOV 17 1969
 MISS. Bd. OF WATER COMMISSIONERS

If well telescopes please
sketch and show depths.

GROUND LEVEL

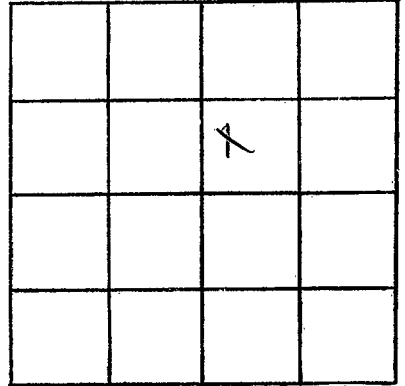

SECTION 25

Please indicate well location X.

ADDITIONAL INFORMATION

If more than one screen,
show locations of each on sketch.