

Neshoba
F32
5-28-70

MISSISSIPPI
 BOARD OF WATER COMMISSIONERS
 416 North State Street
 Jackson, Mississippi 39201

Coded

WATER WELL DRILLERS LOG

5-28 1970 Beck Smith Neshoba
 date well completed firm name county well located

LANDOWNER: LEROY JEMISON
Phila, Miss
RT # 3
 (mailing address)

description of formations encountered	from	to
<u>RED CLAY</u>	<u>0</u>	<u>40</u>
<u>BLUE CHALK</u>	<u>40</u>	<u>148</u>
<u>SAND</u>	<u>148</u>	<u>160</u>

WELL LOCATION
 ? sec. 1 T. 2 N. R. 11 E.
3 miles NW of Phila
 (distance) (direction) (nearest town)

Phone book has address
 as Aug 21 N
 Sec. 11N, 12E

WELL PURPOSE: home
 (home, irrigation, municipal, industrial)

- WELL COMPLETION DATA:
- (1) diameter (inches) 2"
 - (2) total depth (feet) 160'
 - (3) static water level (feet) 50 below / above top of ground.
 - (4) casing galv 100
 (material) (depth)
— if telescope see back.
 (size)
 - (5) screen open —
 (length) (depth to top)
— (size) — (material)
 - (6) pump LHP —
 (HP) (yield gpm)
ELEC
 (type power)
 - (7) electric log —
 (yes or no)
—
 (organization running log)
 - (8) how well bottom plugged —


JUL 17 1970

DRILLERS REMARKS:

MISS. BD. OF
 WATER COMM.

If well telescopes please sketch and show depths.

GROUND LEVEL

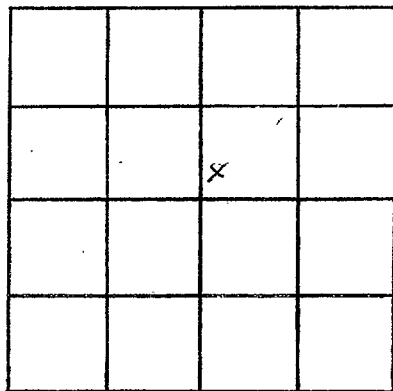

SECTION 1

Please indicate well location X.

ADDITIONAL INFORMATION

If more than one screen,
show locations of each on sketch.