

MISSISSIPPI
BOARD OF WATER COMMISSIONERS
416 North State Street
Jackson, Mississippi 39201

CODED

On 12/17/70
Ord 12-22-70

WATER WELL DRILLERS LOG

NESTOBA
F35
12-1-70

12-1 date well completed
1970 P.B. Nicholson firm name
Neshoba county well located

LANDOWNER: Herman Tucker

Phila -
Miss
(mailing address)

WELL LOCATION:

sec. 33 T. 11 N. R. 1 E
3 1/2 miles West Phila.
(distance) (direction) (nearest town)

WELL PURPOSE: home
(home, irrigation, municipal, industrial)

WELL COMPLETION DATA:

- (1) diameter (inches) 6 1/2"
- (2) total depth (feet) ~~777~~ 467
- (3) static water level (feet) 135 below top of ground.
- (4) casing (material) (depth) Blue, 273
4" (size) If telescope see back.
- (5) screen (length) (depth to top) 0
- (6) pump (size) (material) (HP) (yield gpm) 3 40
- (7) electric log (type power) (yes or no)
- (8) how well bottom plugged open

description of formations encountered	from	to
Clay	0	20
Sand dry	20	40
Chalk & sand	40	54
blue clay	54	113
rock & shell	113	126
blue & sand	126	195
blue dirt	195	280
blue & shell	280	348
rock	348	345
fine sand	345	360
blue dirt	360	420
fine water sand	420	467

CODED

DEC 15 1970


DRILLERS REMARKS:

Well has 160 ft
7" pipe in it

MISS. BD. OF
WATER COMMISSIONERS

If well telescopes please sketch and show depths.

GROUND LEVEL

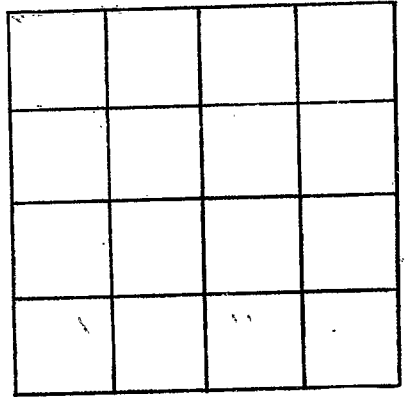

SECTION _____

Please indicate well location X.

ADDITIONAL INFORMATION

If more than one screen, show locations of each on sketch.