

NESHOBBA

F37

7-12-62

WATER WELL DRILLERS LOG

CODED

Date: 7-12, 1962, Driller: P.B. Nicholas County: Neshoba

PR-1 Joe Bell (Name)

(1) Owner of Land: U.S. Govt. Phila. Miss. (Name) (Address)

(2) Location: 1/4, 1/4, Sec. 30 11 N, 7 1/2 miles west of Phila. (distance) (direction) (Nearest Town)

(3) Topography: Hilly (Hilly) (Flat) (Level)

(4) Purpose of Well: Domestic (Domestic Irrigation, Municipal, Industrial, Other)

Description & Color of Materials Sand, Clay, Red Clay, Shell, etc.	Thick- ness Feet	Depth Feet.
Clay & Chalk	1	25
Mix Clay & Sand	25	50
Water Sand	50	65

CODED

Information upon completion of well:

(1) Diameter 3 1/8 inches.

(2) Total Depth 65 feet.

(3) Water Level 45 feet below top of ground.

(4) Cased to Joint, Size 2"


(5) Screen: Size 2", Length 5'

(6) Were any formations sealed against pollution? yes, no.

If YES depth of formation 10' of 4" size

Why: Sanitary Purpose

Drillers Remarks: Cylinder set at 52 ft

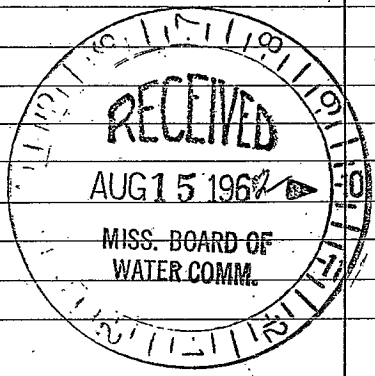

(Use Back Side)

Well No.

Handwritten notes at the top of the page, including the word "SPECIAL" and other illegible scribbles.

Handwritten notes in the middle section, possibly including the word "SPECIAL" again.

Vertical handwritten notes on the right side of the page.

Handwritten notes at the bottom of the page, including the word "SPECIAL" and other illegible scribbles.