

NESHOBAY

F 38

8-15-62

WATER WELL DRILLERS LOG

CODED

Date: 8-15, 1962 Driller: P R Nicholson County Neshoba
P R-58 Homer Jimmie (Name)

(1) Owner of Land: U.S. Goult
 (Name)
 Phila. Miss -
 (Address)
 1911 11

(2) Location: 1/4, 1/4, Sec. T R
 7/8 miles west of Phila.
 (distance) (direction) (Nearest Town)

(3) Topography: Hilly
 (Hilly) (Flat) (Level)

(4) Purpose of Well: Domestic
 (Domestic Irrigation
 Municipal, Industrial, Other)

Description & Color of Materials Sand, Clay, Red, Clay, Shell, etc.	Thick- ness Feet	Depth Feet
Chalk & Clay	1	8
Shell & Chalk	8	20
Mix Sand & Chalk	20	38
Blue dirt	38	74
Black dirt	74	100
Water Sand	100	118

CODED

Information upon completion of well:

(1) Diameter 3 7/8 inches.


(2) Total Depth 118' feet.

(3) Water Level 85' feet below top of ground.

(4) Cased to Joint, Size 2"

(5) Screen: Size 2", Length 5'

(6) Were any formations sealed against pollution?
 yes, no.

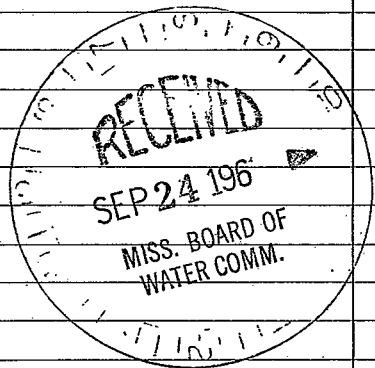

If YES depth of formation 10ft 4" pipe

Why Sanitary purpose

Drillers Remarks: Cylinder set
100 ft

Well No.

(Use Back Side)

