

F 39

8-14-62

WATER WELL DRILLERS LOG

CODED

Date: 8-14, 1962, Driller: R.R. Nicholson, County: Neshoba
PR-50 Albert Lewis (Name)

(1) Owner of Land: U.S. Govt.
 (Name)
Shila Miss.
 (Address)
30 1111

(2) Location: 1/4, 1/4, Sec. T, R. R
7/4 miles west of Shila
 (Distance) (direction) (Nearest Town)

(3) Topography: Hilly
 (Hilly) (Flat) (Level)

(4) Purpose of Well: Domestic
 (Domestic Irrigation
 Municipal, Industrial, Other)

Description & Color of Materials Sand, Clay, Red Clay, Shell, etc.	Thick- ness Feet	Depth Feet
Rock	1	23
Shell & blue	23	40
Mud blue & sand	40	55
Water Sand	55	69

CODED

Information upon completion of well:

(1) Diameter 3 7/8 inches.

(2) Total Depth 69 feet.

(3) Water Level 54 feet below top of ground.

(4) Cased to Joint, Size 2"


(5) Screen: Size 2", Length 5'

(6) Were any formations sealed against pollution?
 yes, no.

If YES depth of formation 10'-4" pipe

Why Sanitary Purpose

Drillers Remarks: Cylinders set
62 ft

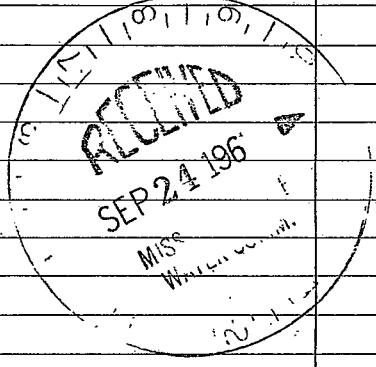

(Use Back Side)

Well No.

[The page contains extremely faint, illegible text, likely bleed-through from the reverse side of the document. The text is scattered across the page and cannot be transcribed.]